


T.I.S.R.I.W.W.M.

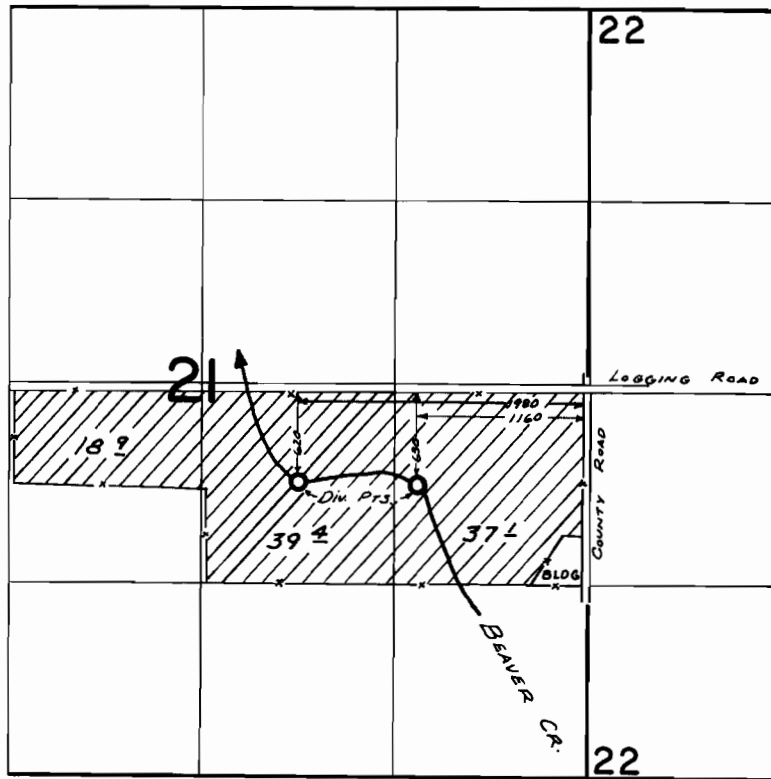

FINAL PROOF SURVEY UNDER

Application No. 41302 ... Permit No. 30841
IN NAME OF

LEIGH F. OR ROSE E. SMITH

Surveyed July 2, 1969, by W. RUPPERT