


Application No 6515

Permit No 4069

cert 5733

Township 4S,

Range 13E.

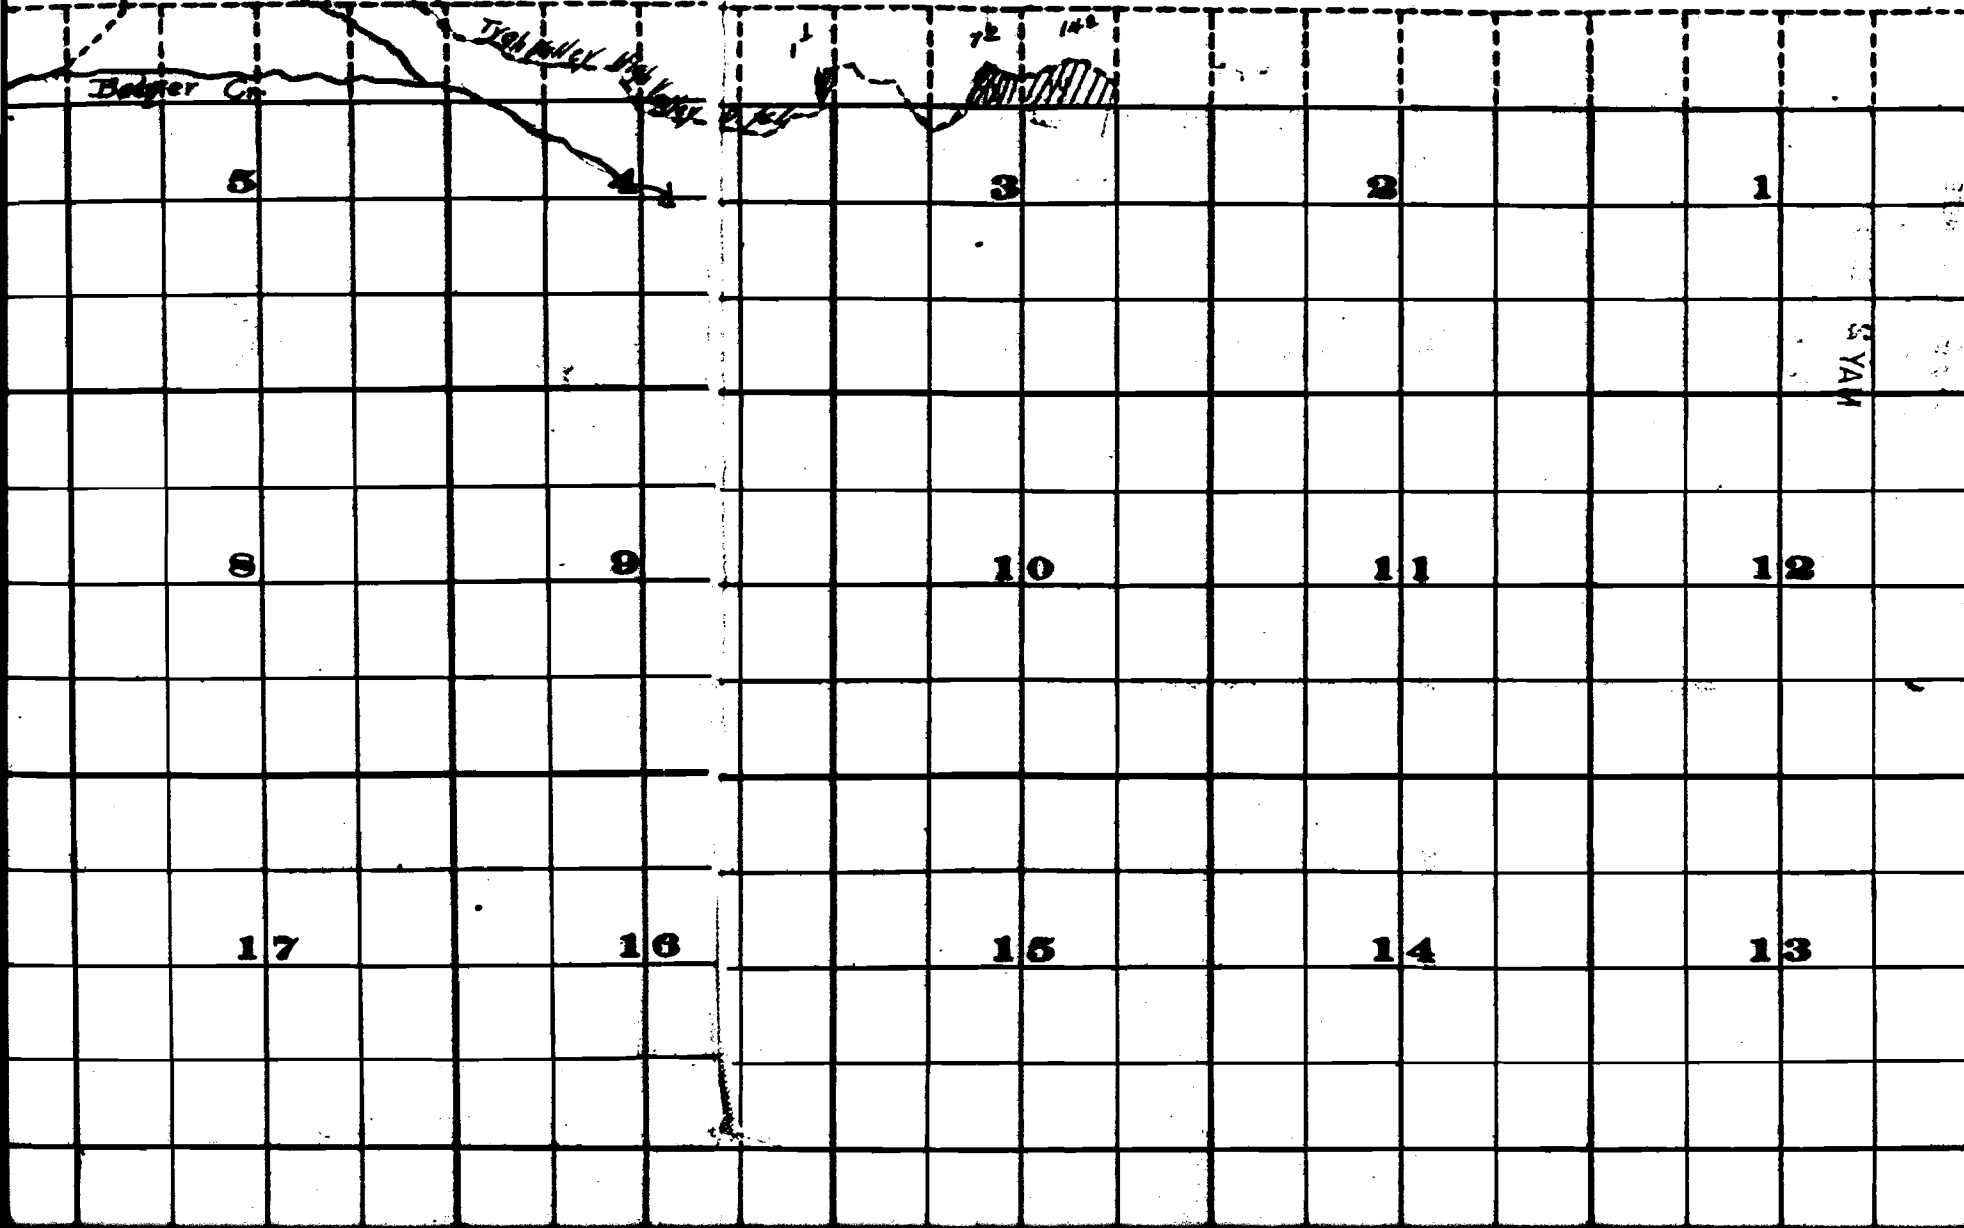

2212