


T.10S.R.1&2W.W.M.
T.11S.R.1&2W.W.M.

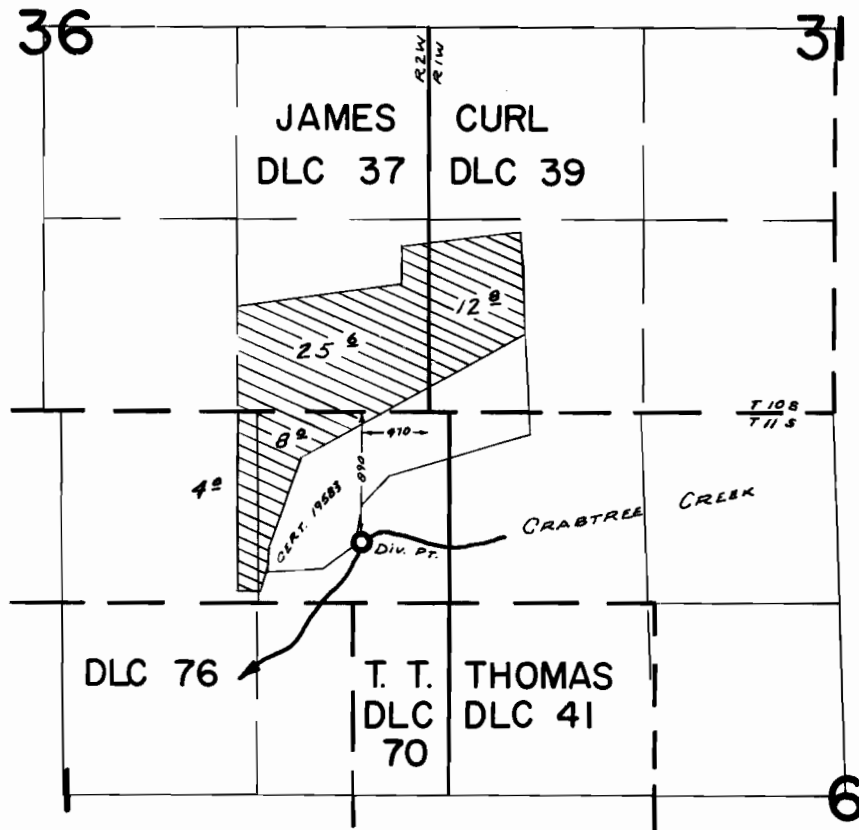

FINAL PROOF SURVEY
UNDER

Application No. 41954 Permit No. 31410
IN NAME OF

RAYMOND M., VIVIAN B. & DANIEL L. GRANT

Surveyed APR. 19. 1969, by W. RUPPERT.