


T.10S.R.2W.W.M.

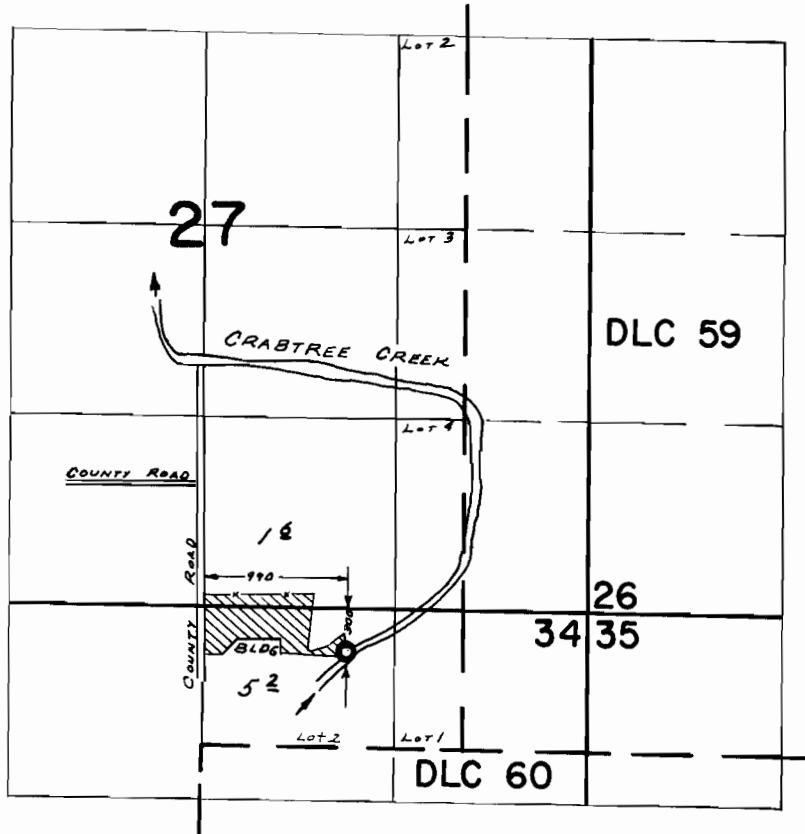

FINAL PROOF SURVEY
UNDER

Application No. 42620... Permit No. 31837...
IN NAME OF

CALVIN & BILLIE McCOWN

Surveyed MARCH 19, 1969, by W. RUPPERT.