


T.I.S.R.I.E.W.M.

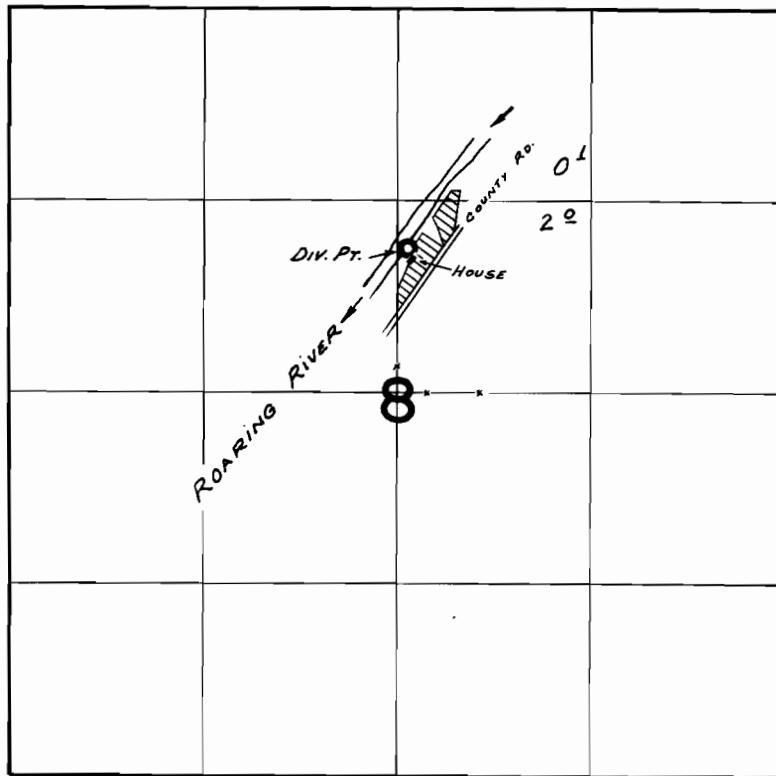

DIV. PT. LOCATED: 990' N. & 60' E. FROM CEN. SEC. 8

FINAL PROOF SURVEY
UNDER

Application No. 43046 Permit No. 32167
IN NAME OF

LAWRENCE C. O'NEILL

Surveyed APR. 11 19.69, by W. RUPPERT