


T.12S.R.4W.W.M.

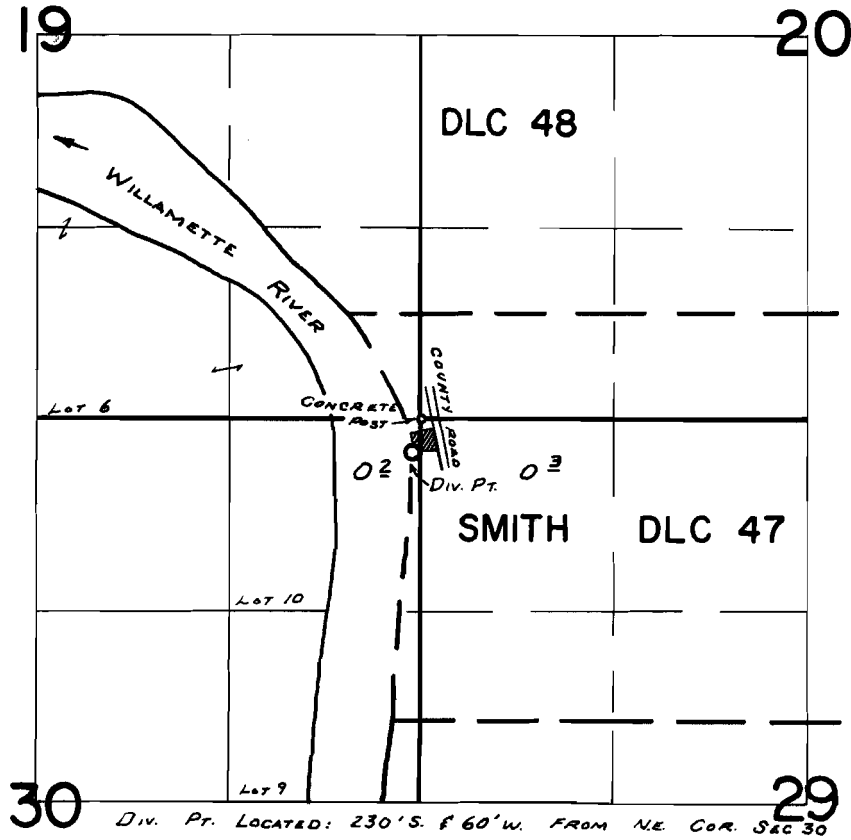

FINAL PROOF SURVEY
UNDER

Application No. 434.06... Permit No. 32526...
IN NAME OF

.....**DON MINORE**.....

Surveyed JUNE 30, 1969, by W. RUPPERT