


T.I.O.S.R.I.W.W.M.

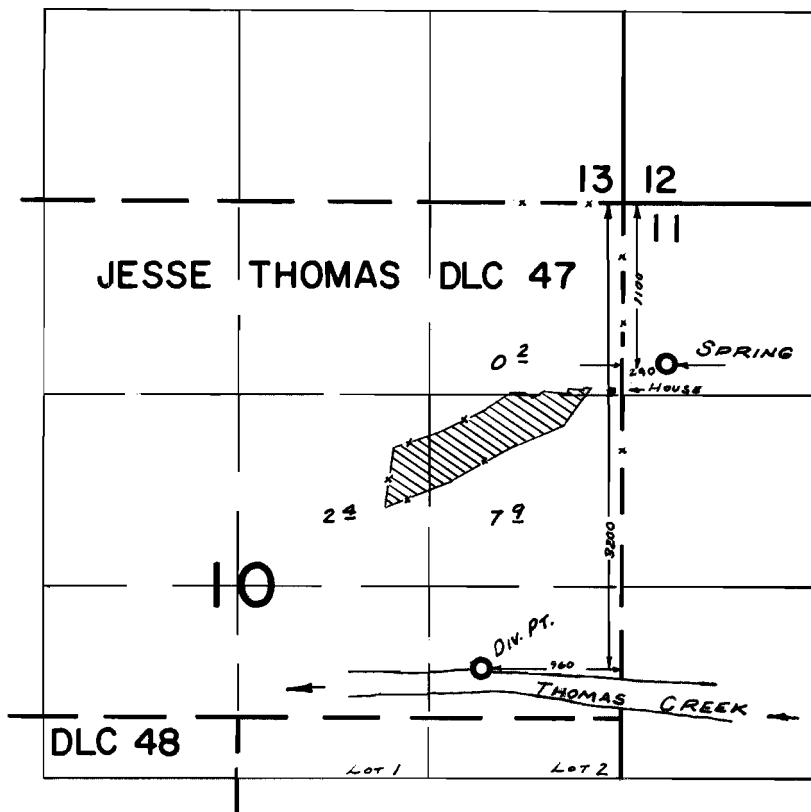

FINAL PROOF SURVEY UNDER

Application No. 43831 Permit No. 32553
IN NAME OF

RAYMOND A. & JOAN M. SILBERNAGEL

Surveyed APRIL 1, 1969, by W. RUPPERT