T.10S.R.2W.W.M.

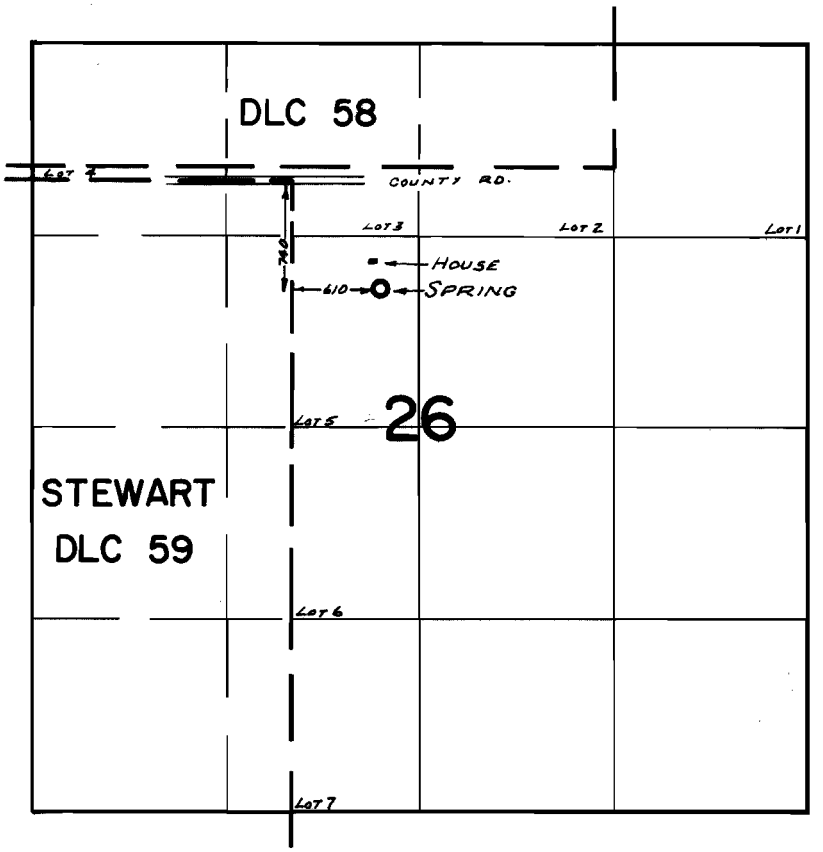

FINAL PROOF SURVEY
UNDER

Application No. 44242 Permit No. 32601
IN NAME OF

RICHARD V. & ALLICE E. KIRKPATRICK

Surveyed MAR. 27, 1969, by W. RUPPERT

B.M.
1969-J