


# T. 7S. R. 4W. W.M.

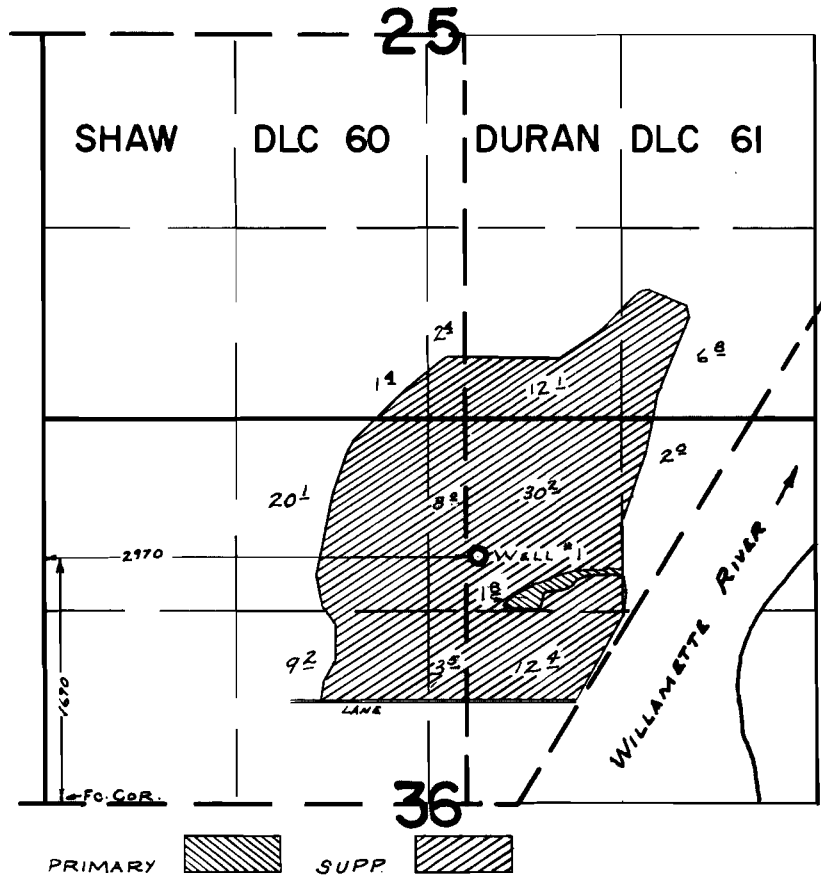

## FINAL PROOF SURVEY UNDER

Application No. *G-2912* Permit No. *G-2730*  
IN NAME OF

**GREEN VILLA FARMS**

Surveyed *Aug. 11, 1969*, by *D. BUELL*