


T. 9 S. R. 5 W. W.M.

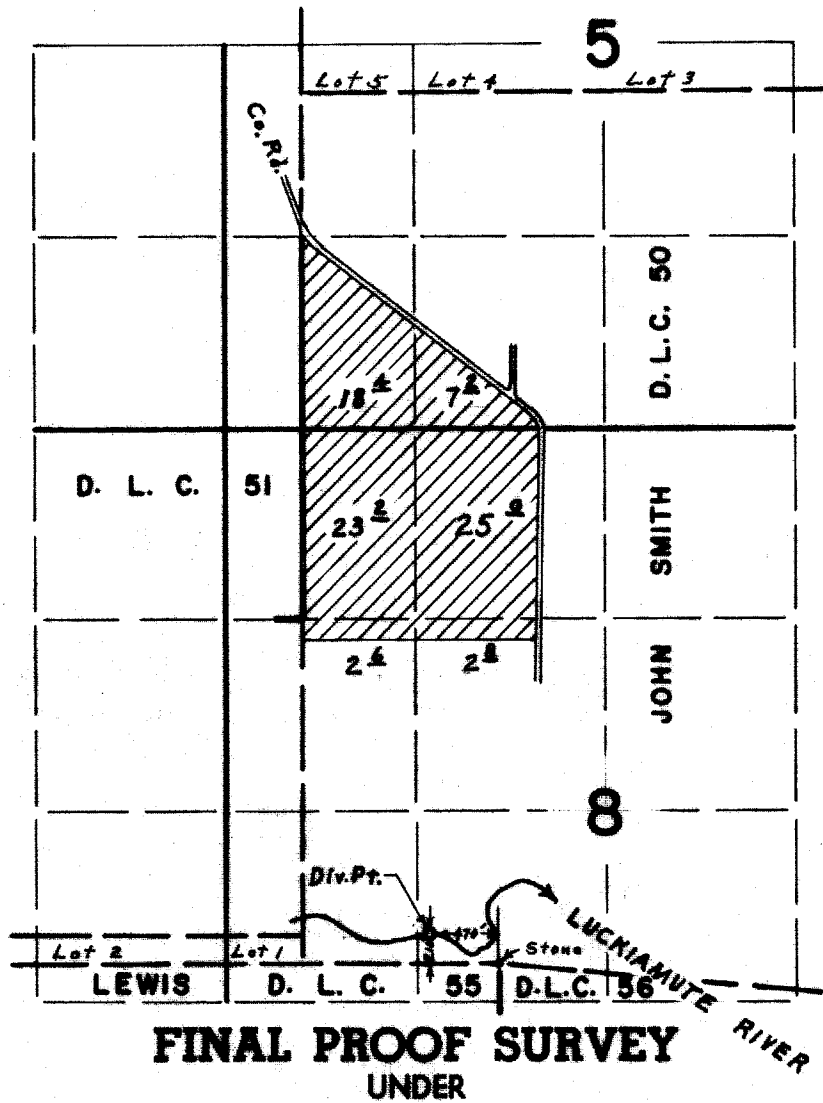

Application No. 38152... Permit No. 28442
 IN NAME OF
H. H. RATZLAFF

Surveyed March 18, 1969, by L. E. Gould...