


T. 9 S. R. 5 W. W. M.

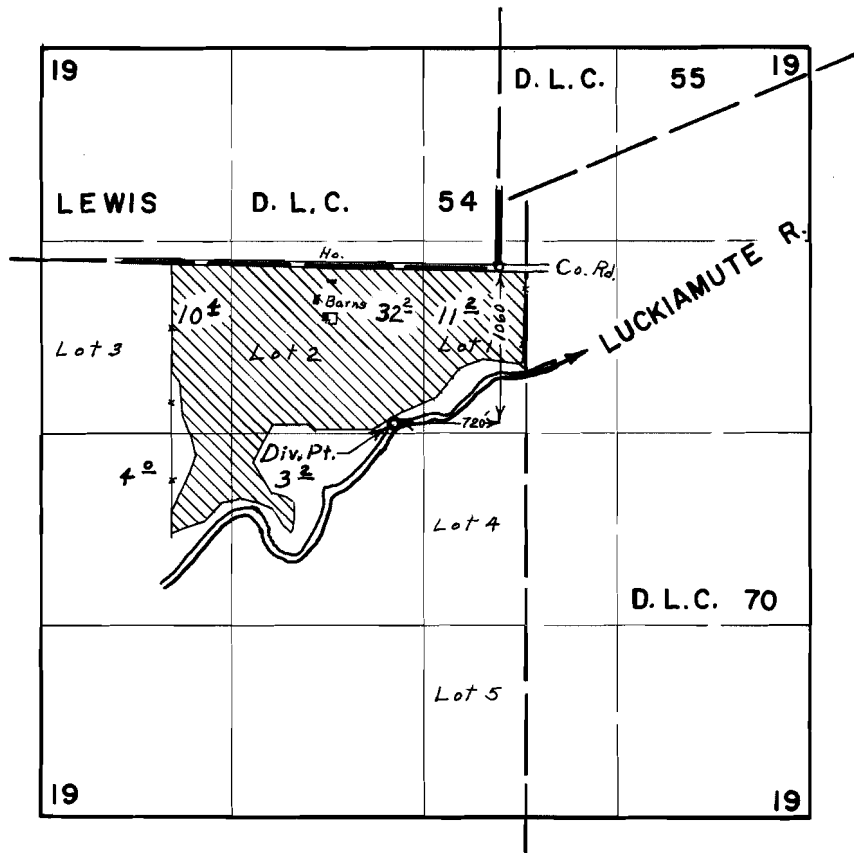

FINAL PROOF SURVEY UNDER

Application No. 40851... Permit No. 30454
IN NAME OF

VERNON MEYER

Surveyed March 21, 1969, by L. E. Gould