


T. 9 S. R. 5 W. W.M.

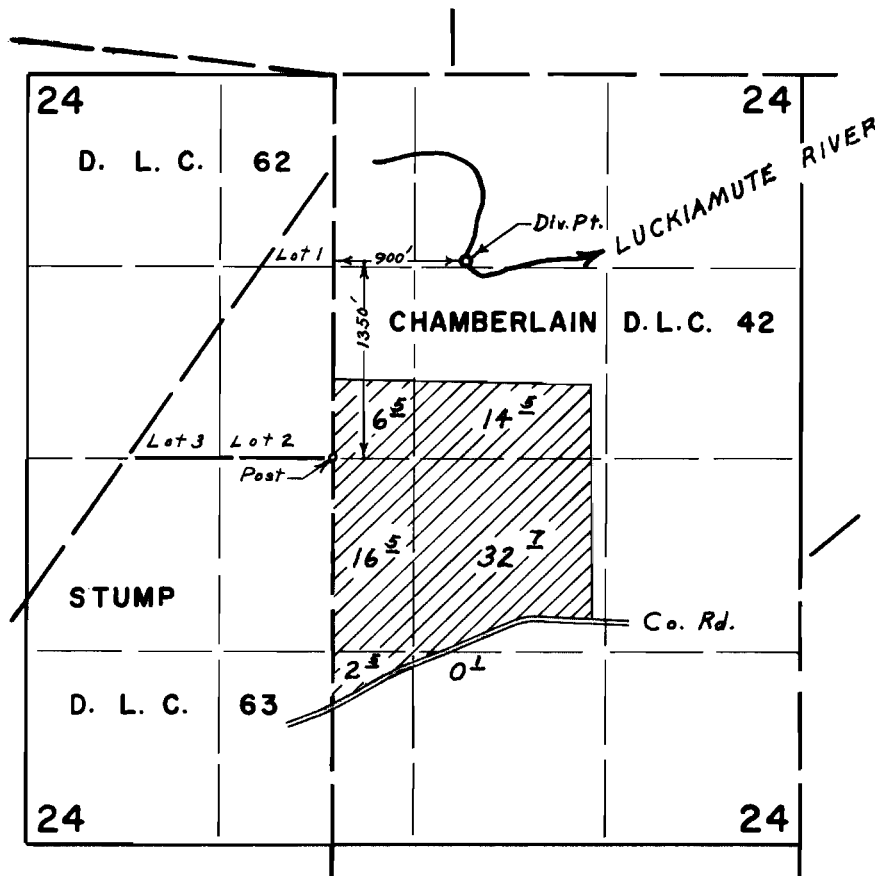

FINAL PROOF SURVEY UNDER

Application No. 41156 Permit No. 30682
IN NAME OF

JOHN C. & DOROTHY HEFFLEY

Surveyed March 19, 1969, by L. E. Gould.