


T. 9 S. R. 5 W. W. M.

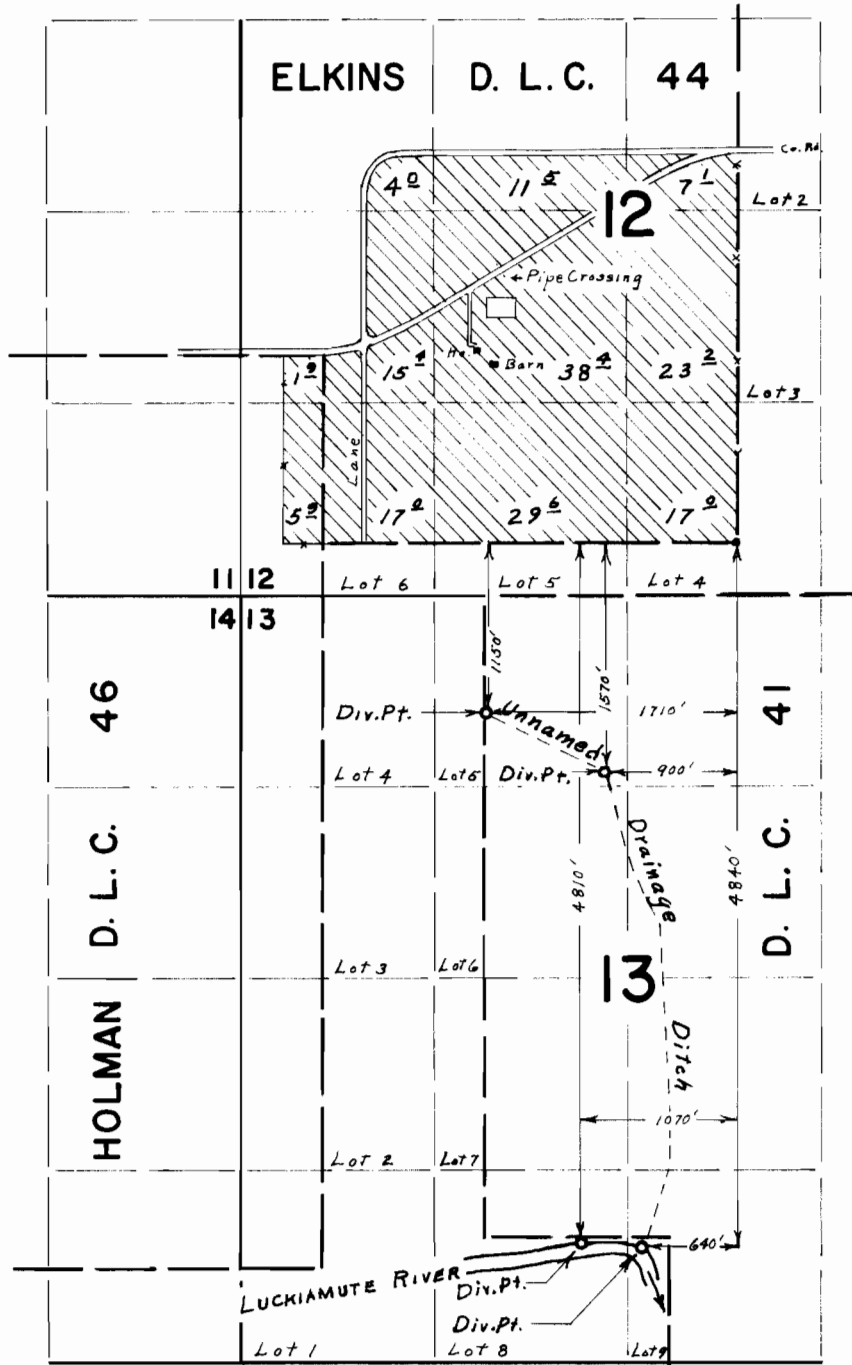

FINAL PROOF SURVEY UNDER

Application No. 42010 Permit No. 31440
 IN NAME OF
LEONARD PETERS

Surveyed March 18, 1969, by L. E. Gould