


T.9S.R.5W. W.M.

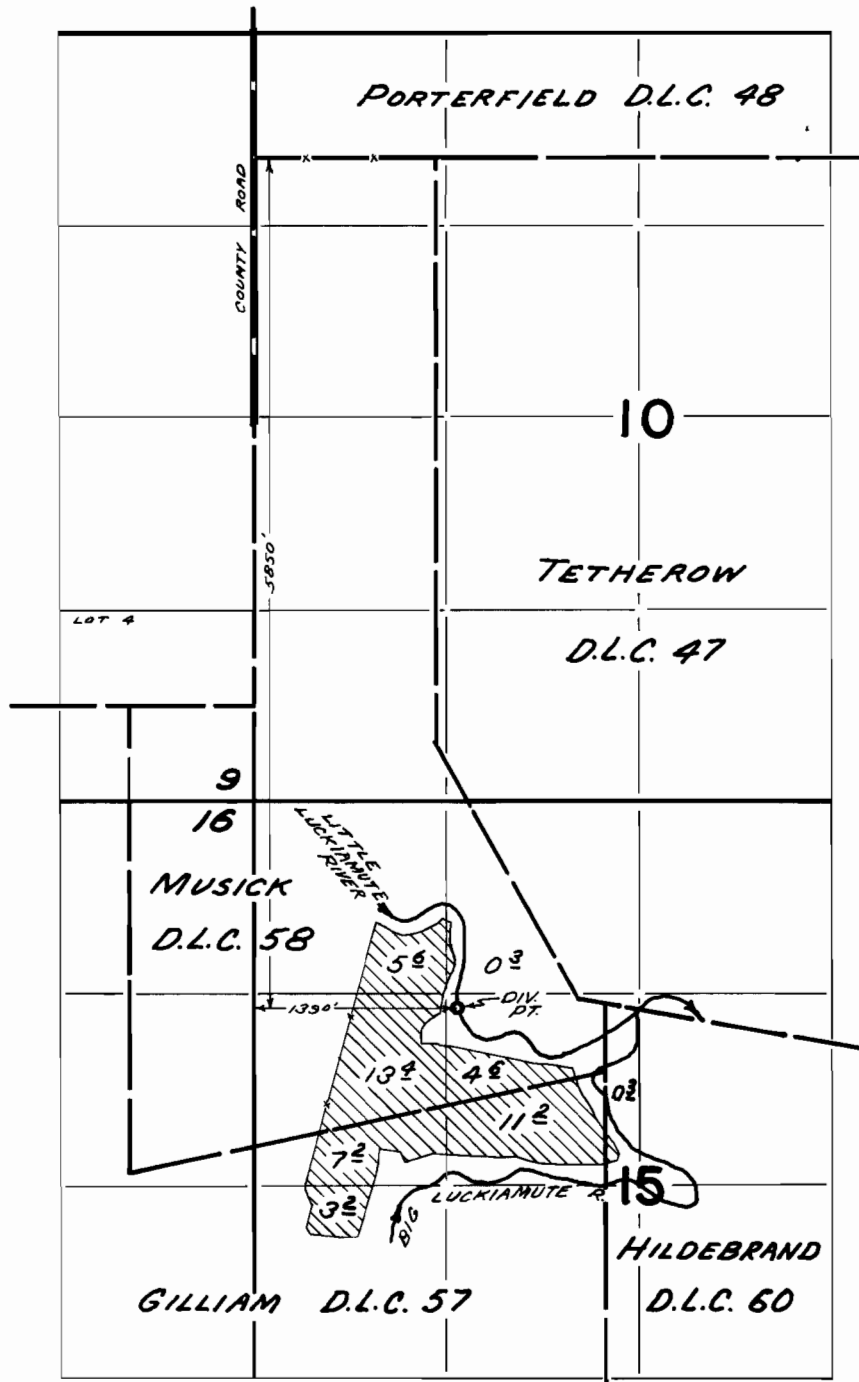

FINAL PROOF SURVEY
UNDER

Application No. 42199 Permit No. 31568
IN NAME OF

VERN RATZLAFF

Surveyed APR. 7, 1969, by D. BUELL