


T.6S.R.6W.W.M.

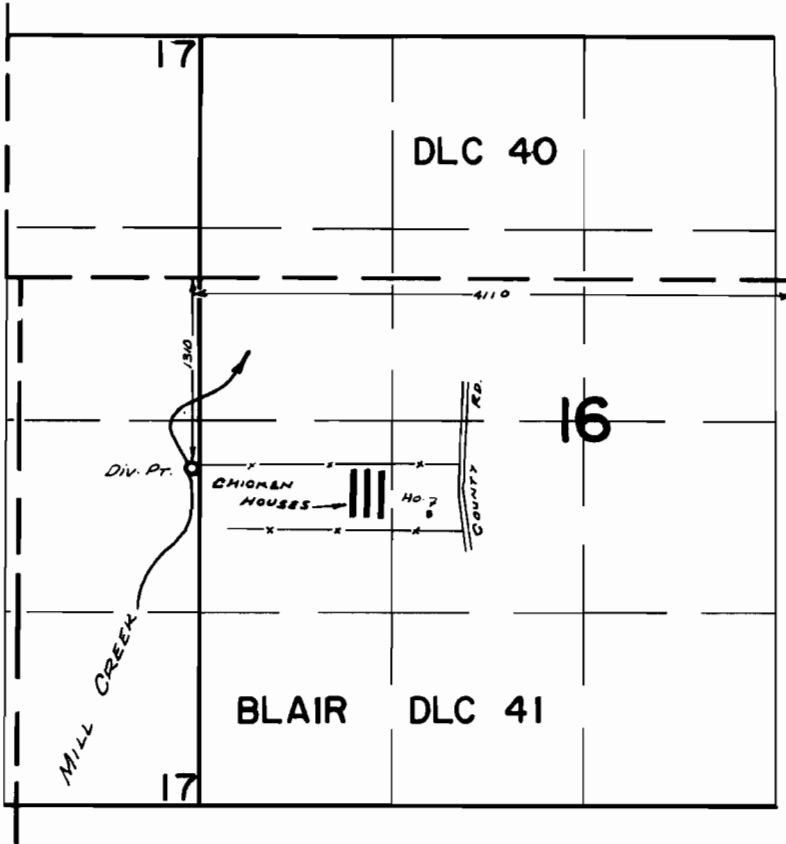

FINAL PROOF SURVEY
UNDER

Application No. 45429 Permit No. 33907
IN NAME OF

LEROY L. KING

Surveyed OCT. 7, 1969, by D. BUELL