


T. 8 S. R. 39 E. W.M.

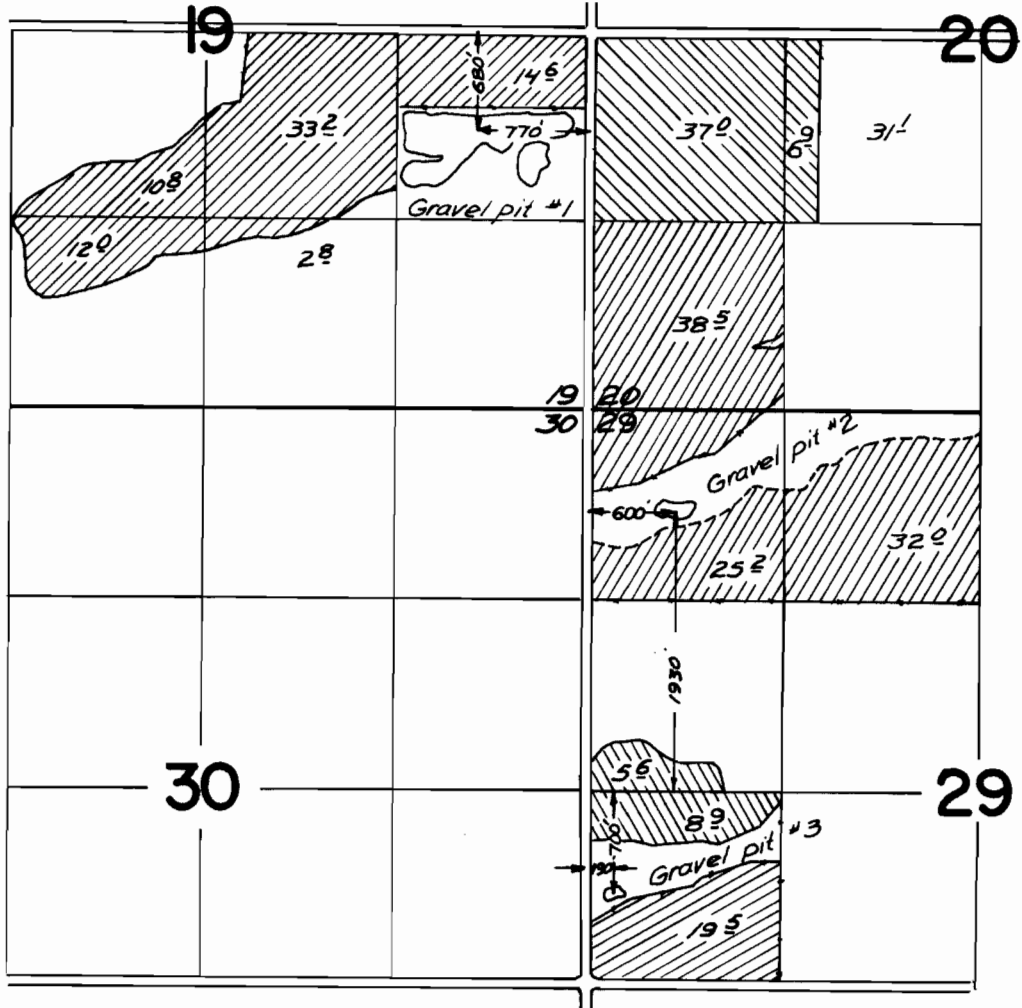

- | | | | | | | | | | |
|--|---------------------------|--|-------------------------|--|-------------------------|--|--------------------------|--|------------------------|
| | <i>Primary
Pit #1</i> | | <i>Suppl
Pit #1</i> | | <i>Suppl
Pit #2</i> | | <i>Primary
Pit 3</i> | | <i>Suppl
Pit 3</i> |
|--|---------------------------|--|-------------------------|--|-------------------------|--|--------------------------|--|------------------------|

FINAL PROOF SURVEY UNDER

Application No. G-3075 Permit No. G-2877
IN NAME OF

NORMAN BUTLER

Surveyed Oct. 25, 26 19.67, by V. Garner