


T. 28S. R.14W. W. M. .

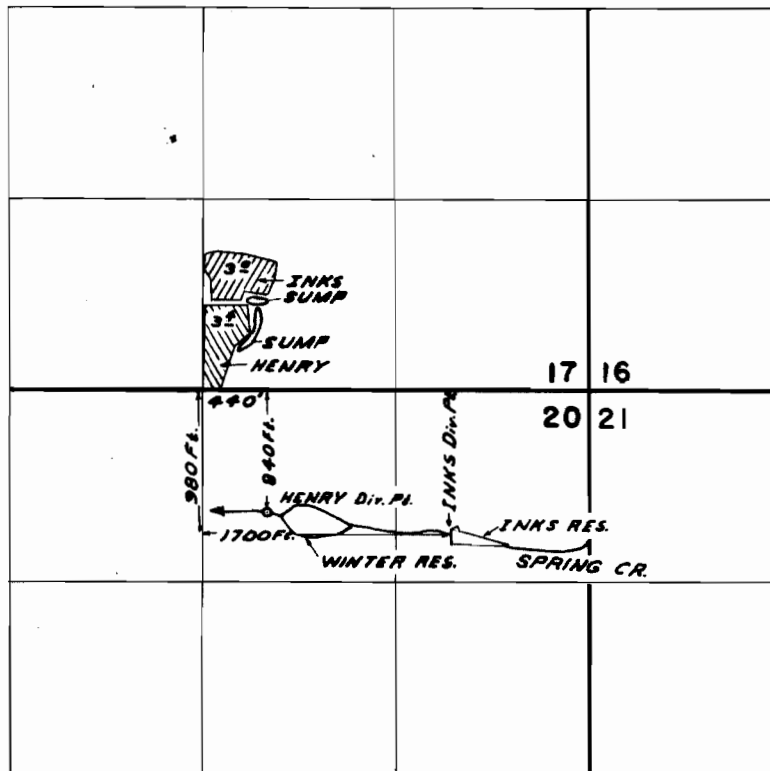

FINAL PROOF SURVEY
UNDER

R-33040

R-2238

Application No. 33041. Permit No. 26134.
IN NAME OF

H. R. INKS & R. M. HENRY

Surveyed 1 AUG 24 1965, by L. COLEBANK