


T.22S. R. 4 W. W.M.

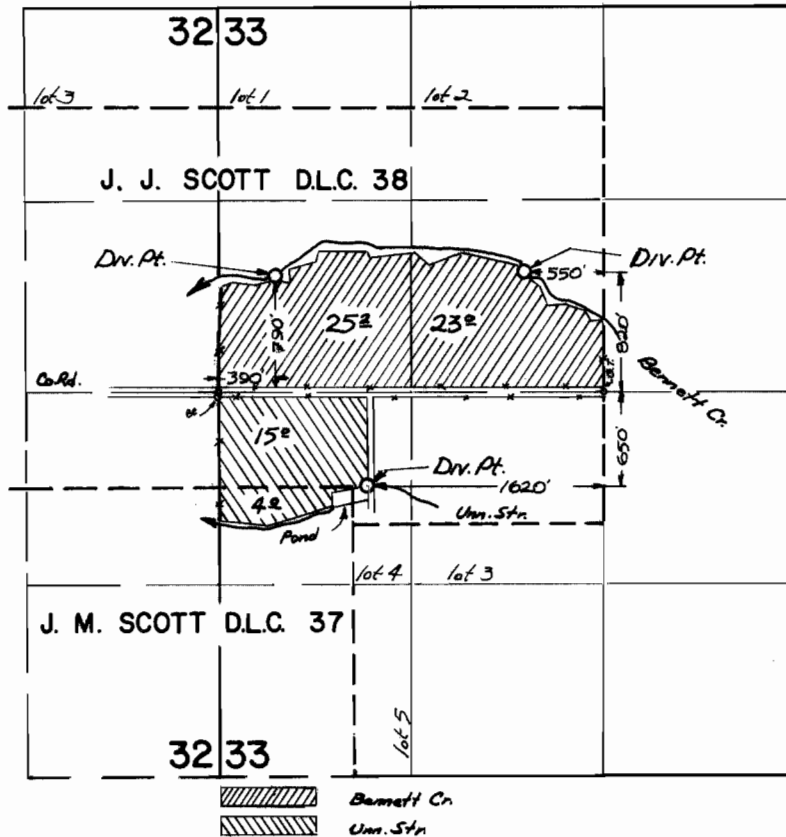

FINAL PROOF SURVEY UNDER

Application No. 38767 Permit No. 28881
 IN NAME OF

RAYMOND & EMALENE MILLER

Surveyed 7 JULY 1969, by W. J. RUPPERT