


SECS. 33 AND 34, T. 36 S., R. 2 W., W.M.

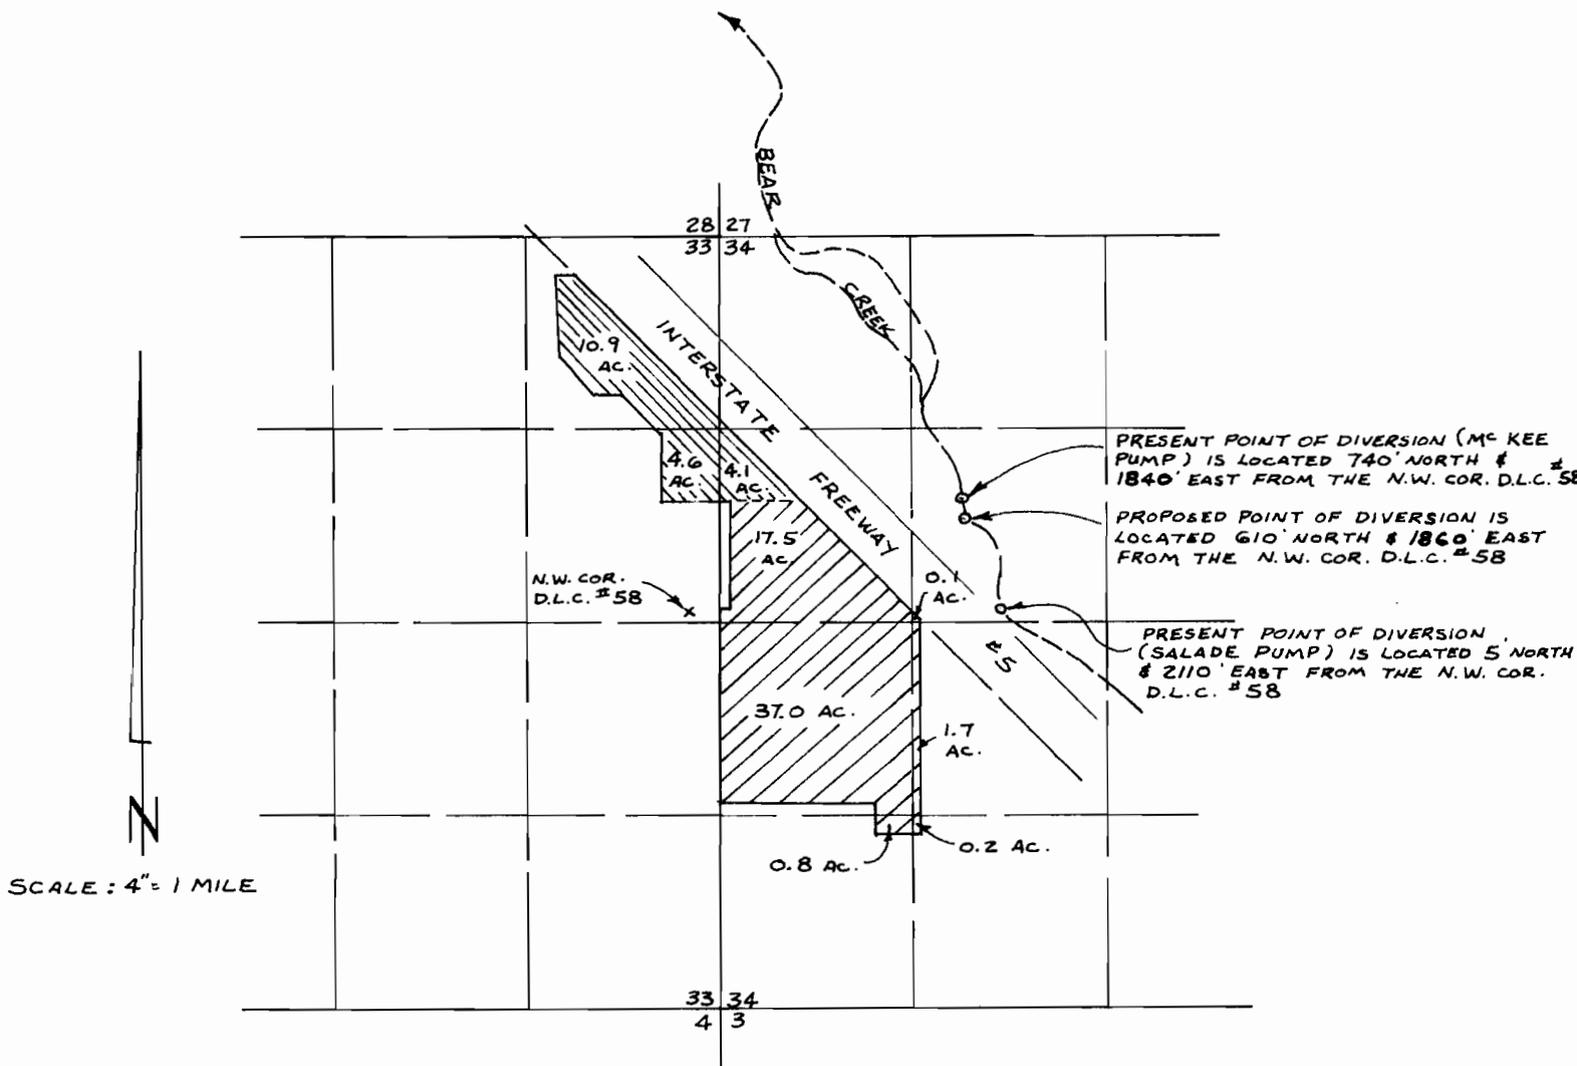

MAP TO ACCOMPANY APPLICATION OF JOHN BOHNERT FOR A CHANGE IN POINT OF DIVERSION FROM BEAR CREEK.

MARCH 5, 1964