


T. 35 S., R. 7 W., W. M.

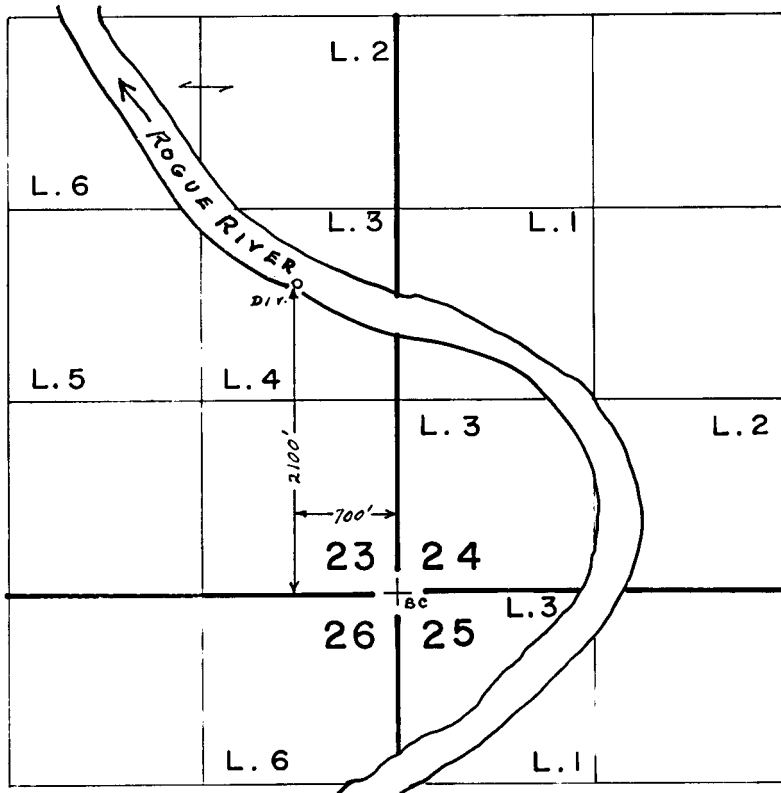

RECEIVED
JUN 27 1986
WM. DIST. 14
GRANTS PASS, ORE.

SCALE: 4" = 1 MILE

FINAL PROOF SURVEY
UNDER

TRANSFER 4338

Application No. Permit No.
IN NAME OF

.....**MARTIN G. BAUER**.....

Surveyed Q.C.T. 2.4 19.8.5, by B.S.**JAMES**...