


T. 20 S. R. 5 W. W.M.

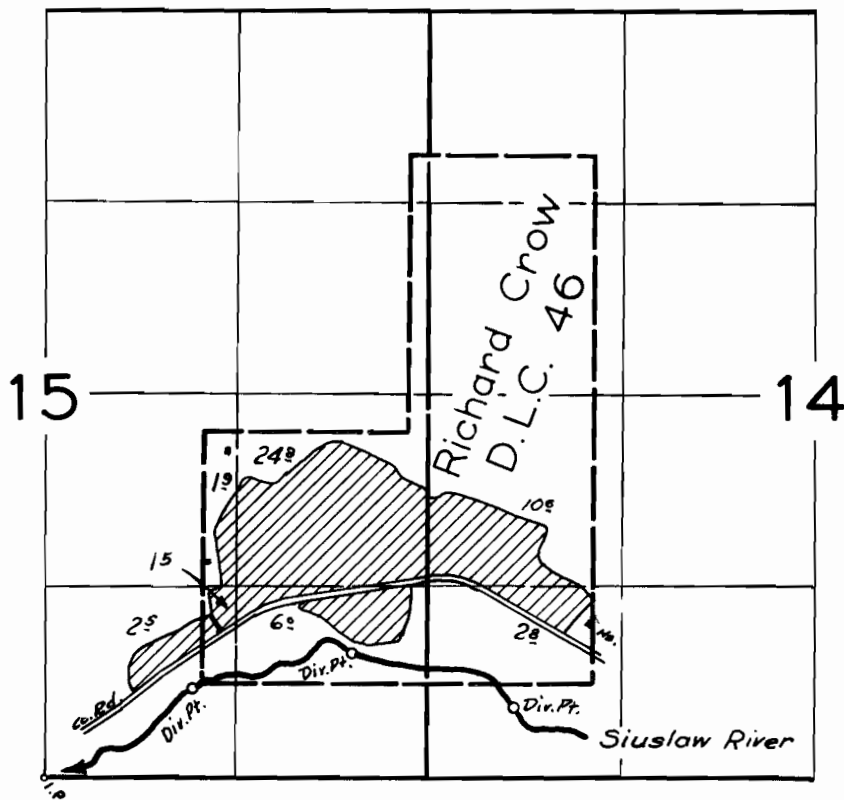

FINAL PROOF SURVEY
UNDER

Application No. 28389. Permit No. 22395.
IN NAME OF

GEORGE L. & ROSS B. DEY

Surveyed Mar. 25 1959, by *R. Jackson*