


T.30S.R.4W.W.M.

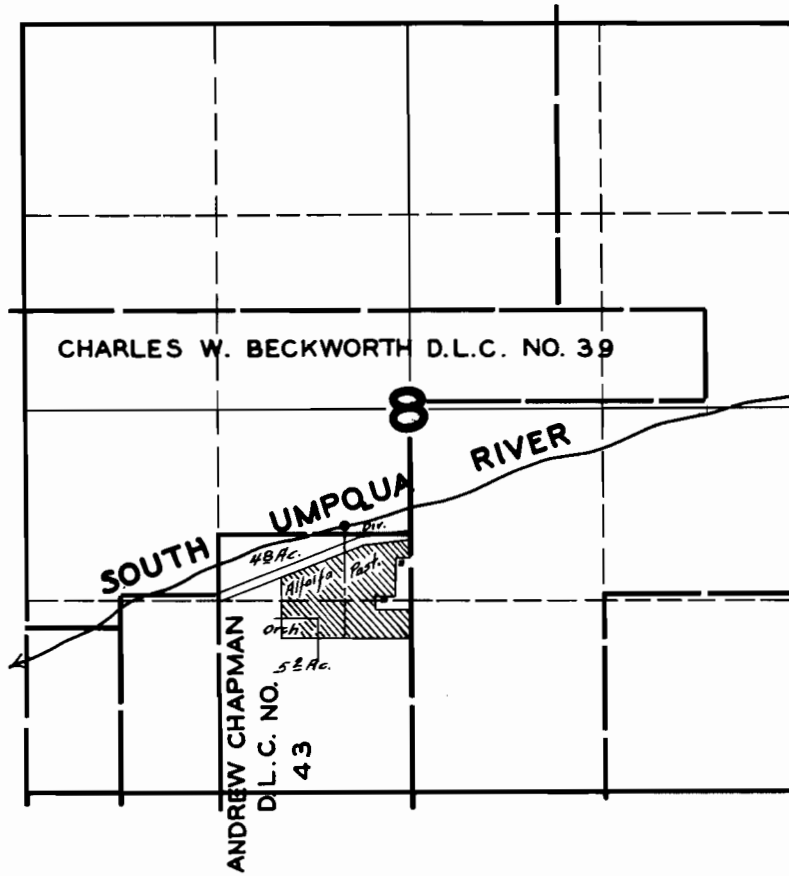

**FINAL PROOF SURVEY
UNDER**

Application No. 21473 Permit No. 16843

IN NAME OF

T. W. ALLEN

Surveyed JUNE 3 1947, by JAS. E. BUNNELL