


T.10S.R.39E.W.M.

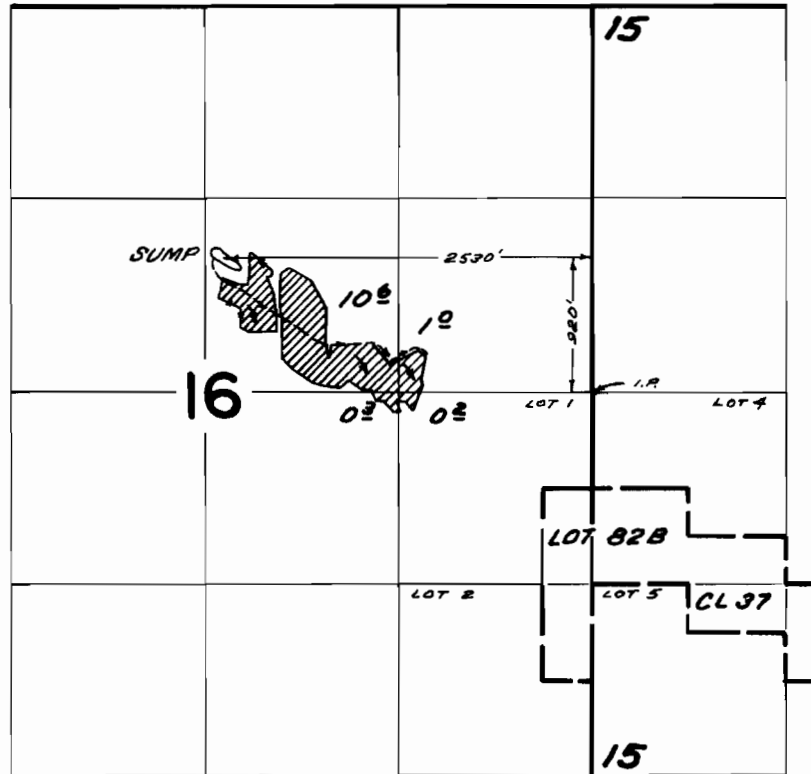

FINAL PROOF SURVEY
UNDER

Application No. G-3072 Permit No. G-2875
IN NAME OF

CLARENCE M. PEARCE

Surveyed JUL. 16, 1969, by D. BUELL