


T. 9 S. R. 40 E. W. M.

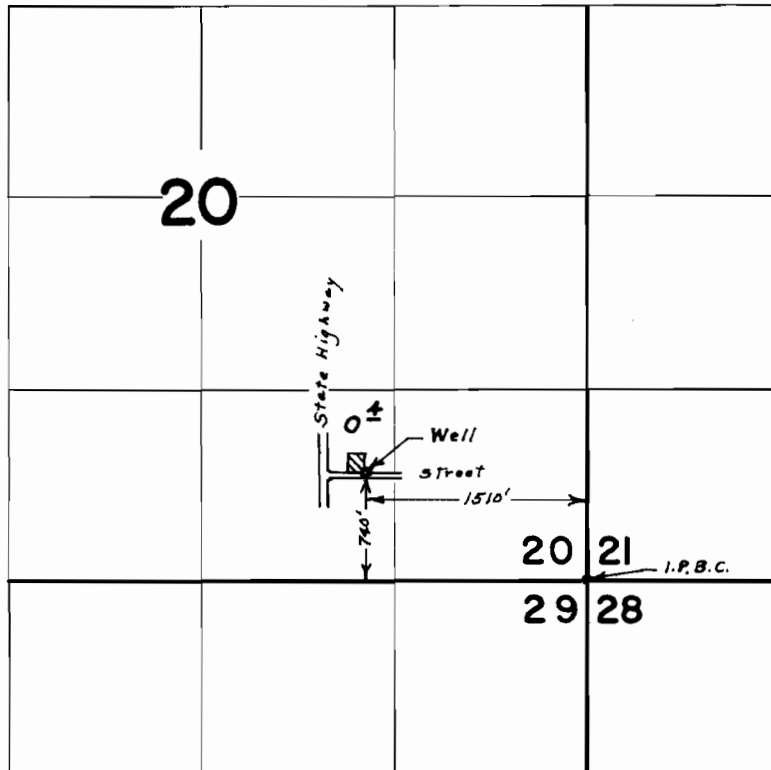

FINAL PROOF SURVEY

UNDER

Application No. G-3128 Permit No. G-2928

IN NAME OF

CLARENCE PEEPLES

Surveyed Aug. 6, 1970, by L. E. Gould