


T.14S.R44E.W.M.

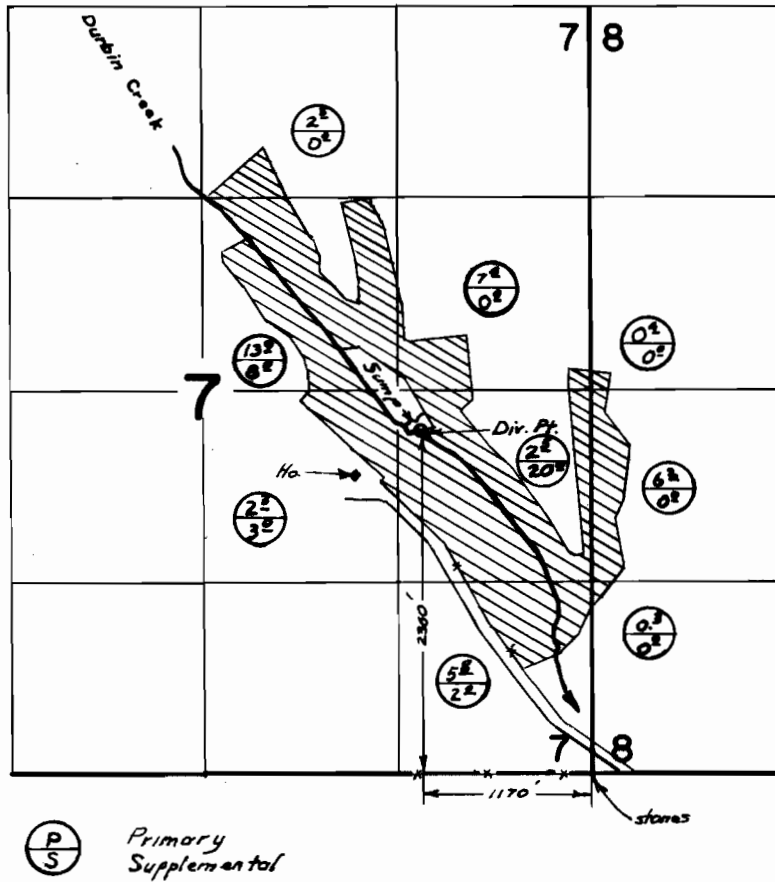

FINAL PROOF SURVEY

UNDER

Application No. G-3881 Permit No. G-3648
IN NAME OF _____

RAY ABRAMS & SONS

Surveyed OCT. 14 1969, by L. E. Gould