


# T. 7 S. R. 39 E. W. M.

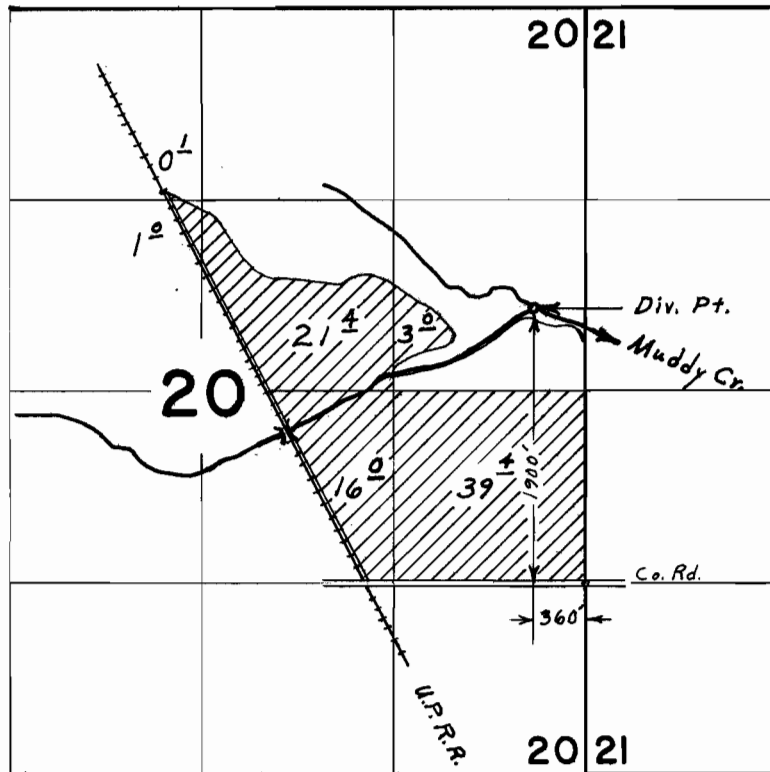

## FINAL PROOF SURVEY

UNDER

Application No. 41720 Permit No. 31148

IN NAME OF

ORVILLE R. FISHER

Surveyed May 15, 1970, by L. E. Gould