


T. 14 S. R. 4 W. W.M.

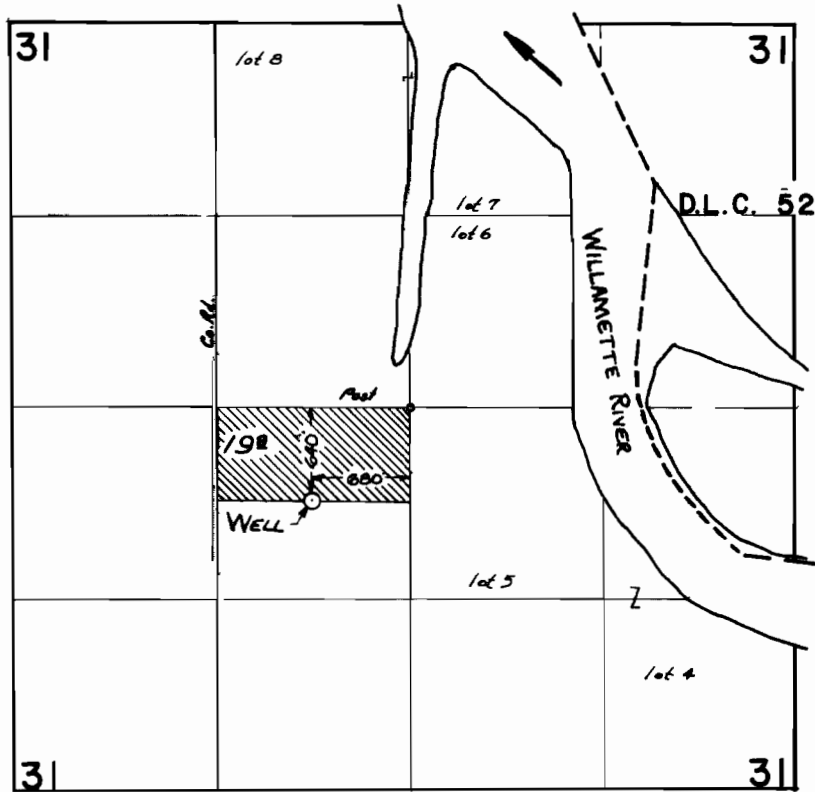

FINAL PROOF SURVEY
UNDER

Application No. G 3200 Permit No. G 3021
IN NAME OF

STEPHEN D. CROWSON

Surveyed 24 MAR. 1970, by L. E. GOULD