


T.11 S., R.5 W., W.M.

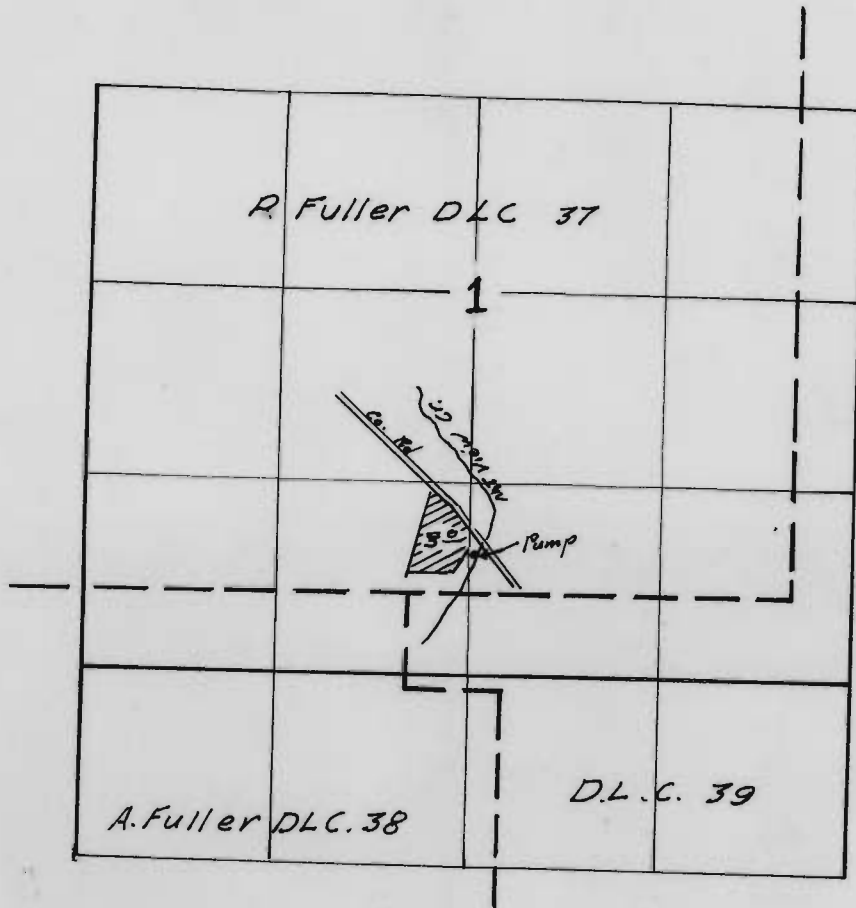

From
Final Proof Survey
Permit No. G-330

Application No. 34861
Permit No. 27362