


T.30S.R.12W.W.M.

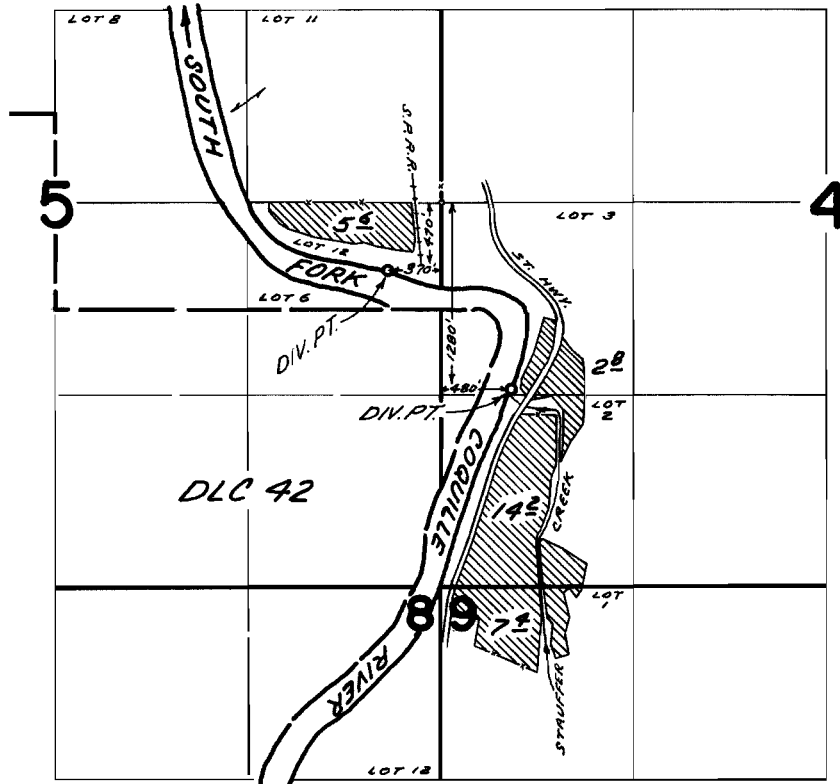

FINAL PROOF SURVEY
UNDER

Application No. 40530 Permit No. 30307
IN NAME OF

ARLIN DELOS HERMANN

Surveyed AUG. 21 1969, by D. BUELL