




T.30S.R.3W.W.M.

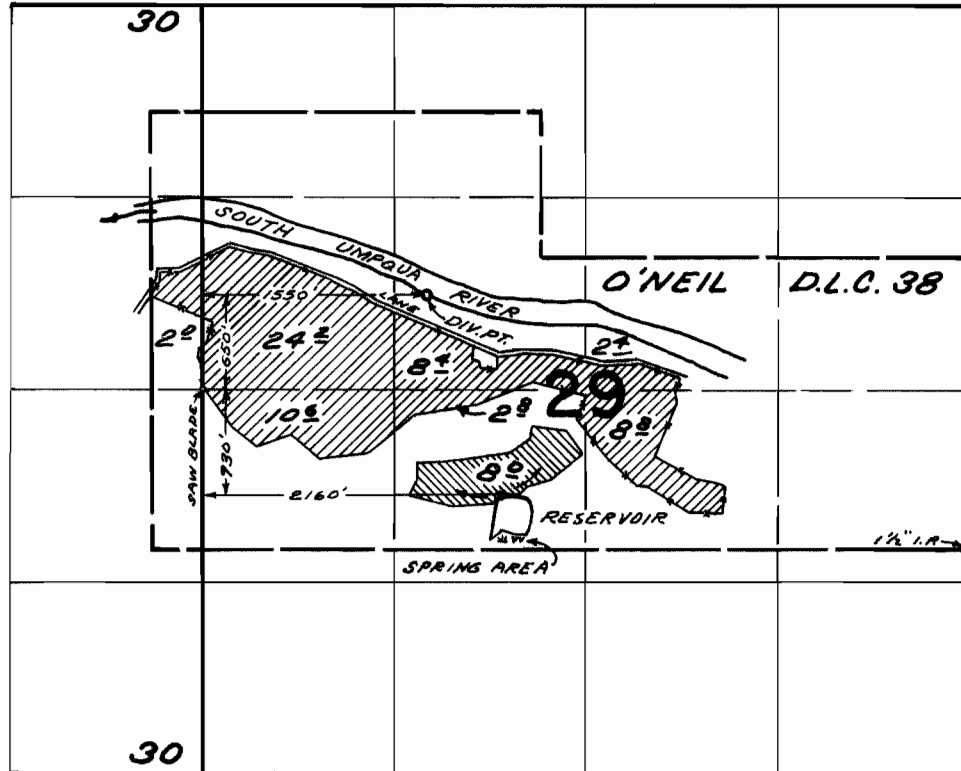

 SPRING & RESERVOIR  RIVER

FINAL PROOF SURVEY UNDER

Application No. R-37978 37979 Permit No. R-3142 28319
IN NAME OF

EARLE E. SOUDAN

Surveyed JUL. 29 1969 by D. BUELL