


T.30S.R.3W.W.M.

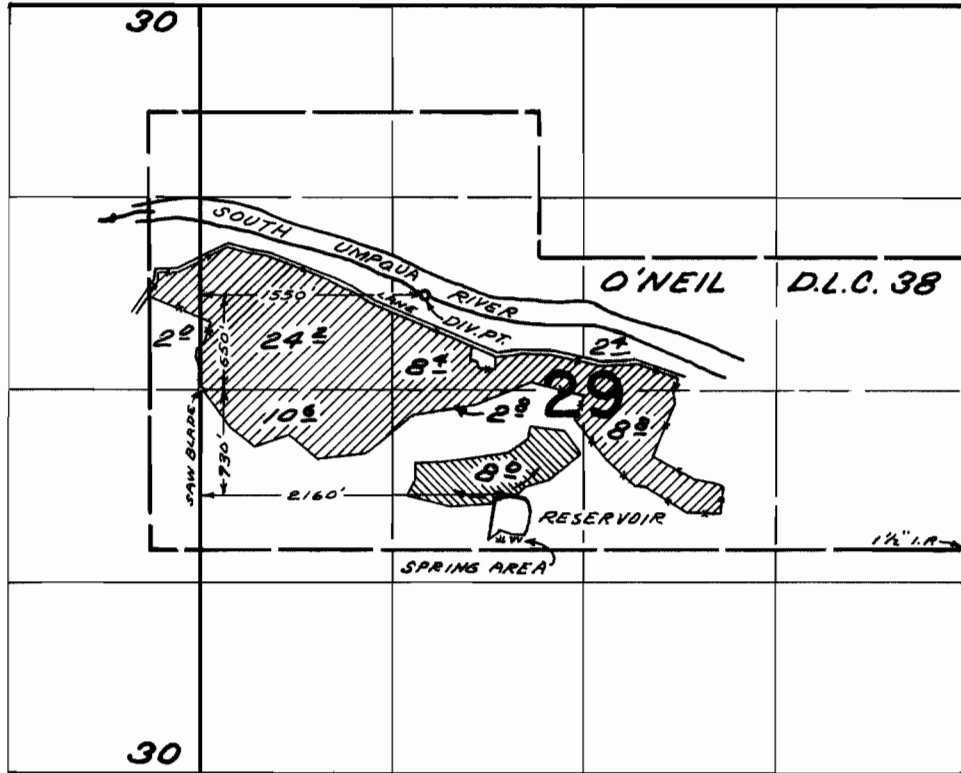

 SPRING & RESERVOIR
  RIVER

FINAL PROOF SURVEY UNDER

Application No. R-37978 37979 Permit No. R-3142 28319
 IN NAME OF

EARLE E. SOUDAN

Surveyed JUL. 29 1969, by D. BUELL