


# T.30S.R.6W.W.M

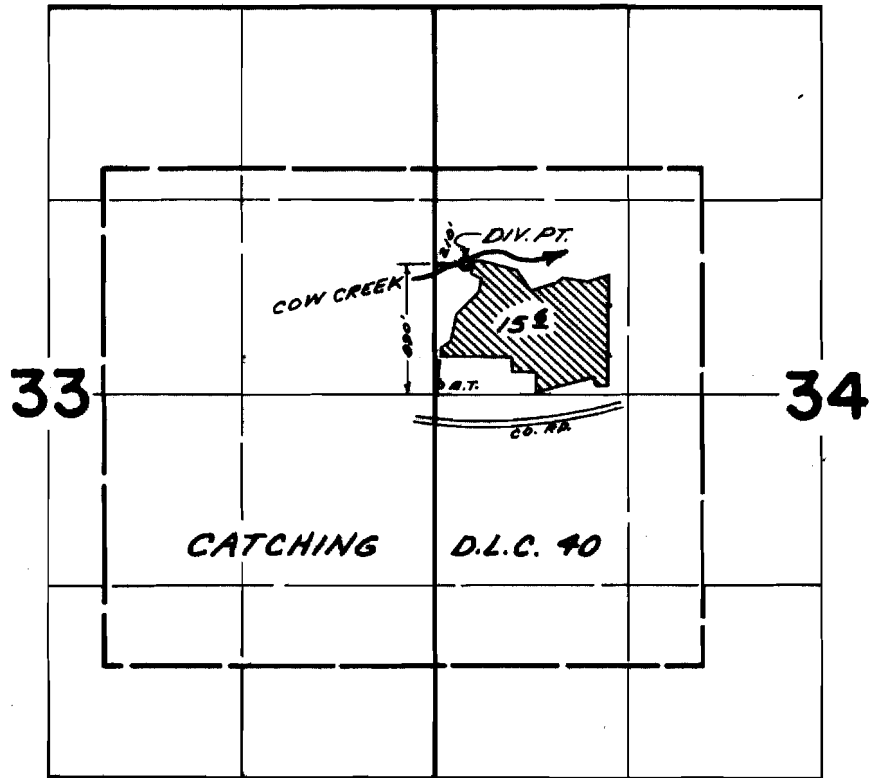

## FINAL PROOF SURVEY UNDER

Application No. 40908 Permit No. 30366  
IN NAME OF

EDWARD W. PARKER

Surveyed APR. 19, 1968, by V. GARNER  
JUN. 23, 1969, D. BUELL