


T.30S.R.2W.W.M.

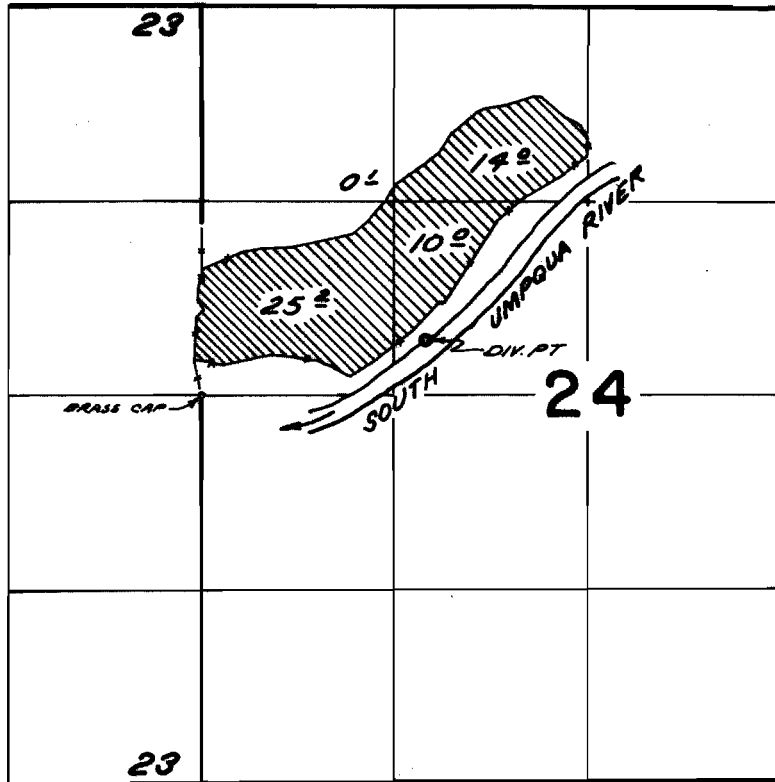

DIV. PT. LOCATED 380 FT. N. & 1540 FT. E. FROM W. 1/4 COR. SEC 24

**FINAL PROOF SURVEY**  
UNDER

Application No. 41960 Permit No. 31913  
IN NAME OF

JOHN G. AND LOLA GIBSON

Surveyed JUL 31 1969, by D. BUELL