


T.29S.R.5W.W.M.

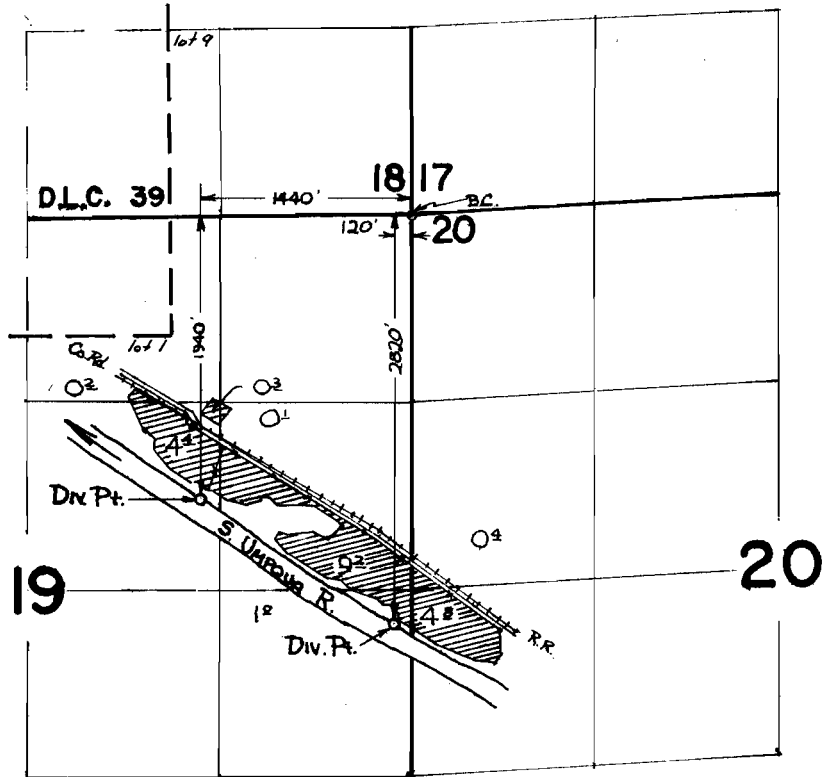

FINAL PROOF SURVEY

UNDER

Application No. 42096 Permit No. 31502

IN NAME OF

MANFRED SVEDBECK

Surveyed 16 JUNE 1970, by D. R. BUELL