


T. 35 & 36 S. R. 4 W. W.M.

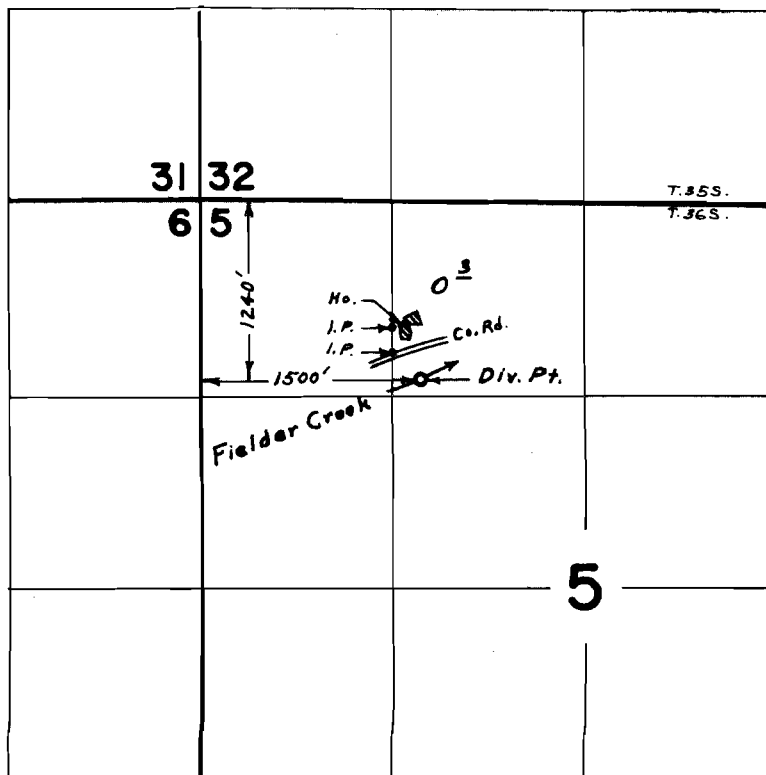

FINAL PROOF SURVEY UNDER

Application No. 40864 Permit No. 30463
IN NAME OF

WARD P. & EDNA I. GREEN

Surveyed June 6, 1969, by L. E. Gould