


T. 36 S. R. 4 W. W. M.

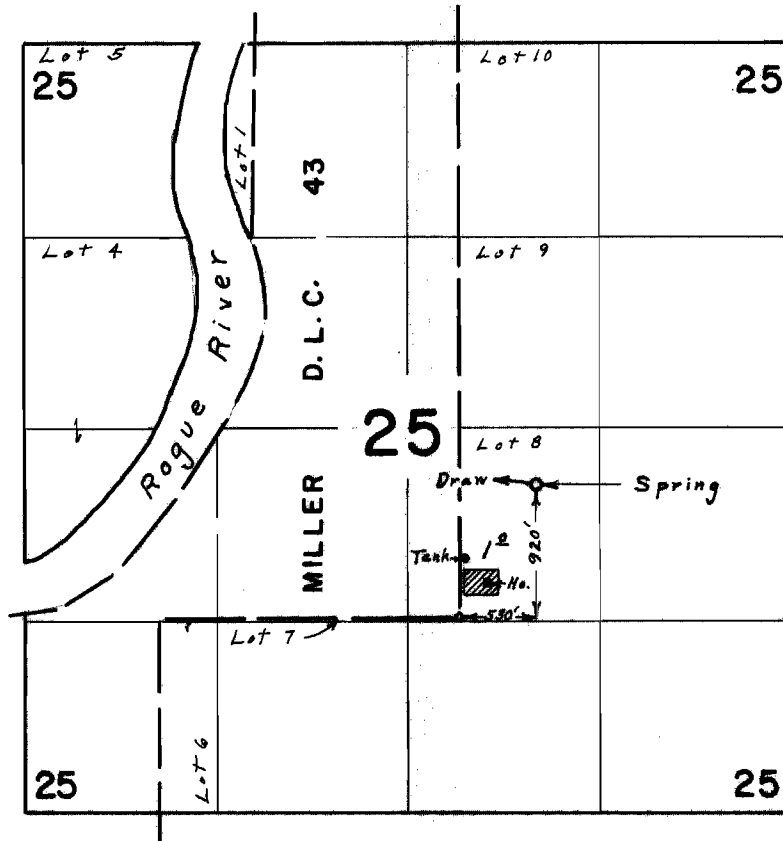

FINAL PROOF SURVEY UNDER

Application No. 43866 Permit No. 32778
IN NAME OF

PAUL F. BALDWIN

Surveyed June 12, 1969, by L. E. Gould