


T. 35 & 36 S. R. 7 W. W.M.

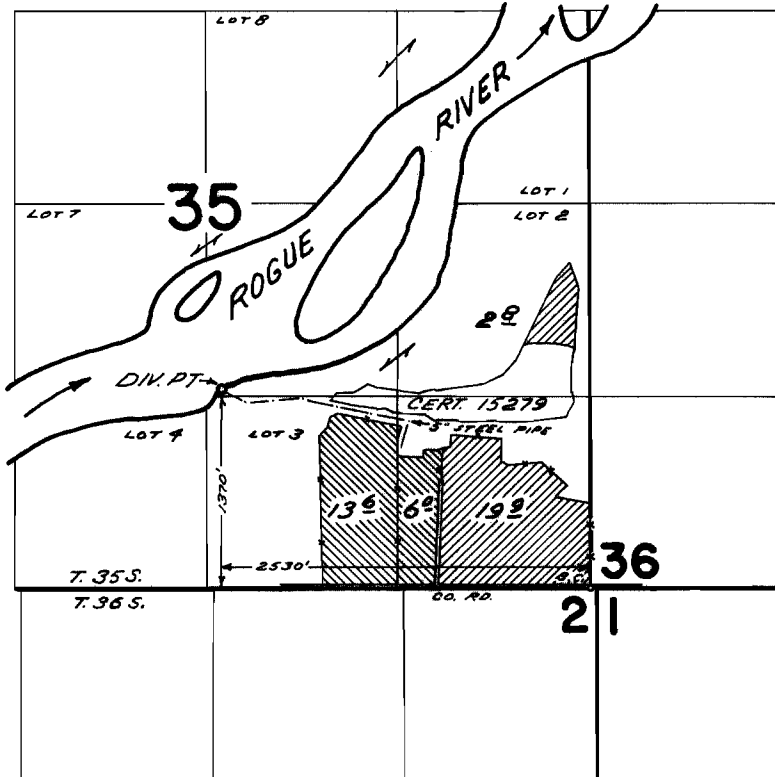

 PERMIT 28470

 PERMIT 28471

FINAL PROOF SURVEY UNDER

Application No. 38210 Permit No. 28470
38211 Permit No. 28471
IN NAME OF

GORDON L. FORSYTHE

Surveyed JUN 5 1969, by D. BUELL