


T. 35&36S.R.7W.W.M.

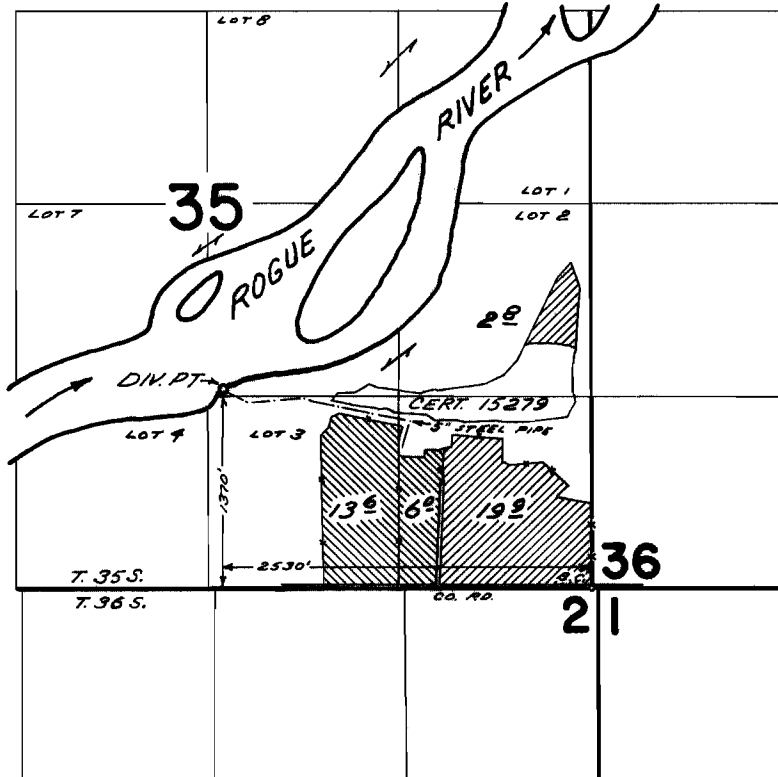

PERMIT 28470



PERMIT 28471

FINAL PROOF SURVEY UNDER

Application No. 38210 Permit No. 28470
38211 Permit No. 28471
IN NAME OF

GORDON L. FORSYTHE

Surveyed JUN 5 1969, by D. BUELL