


T.41S. R.18E. W.M.

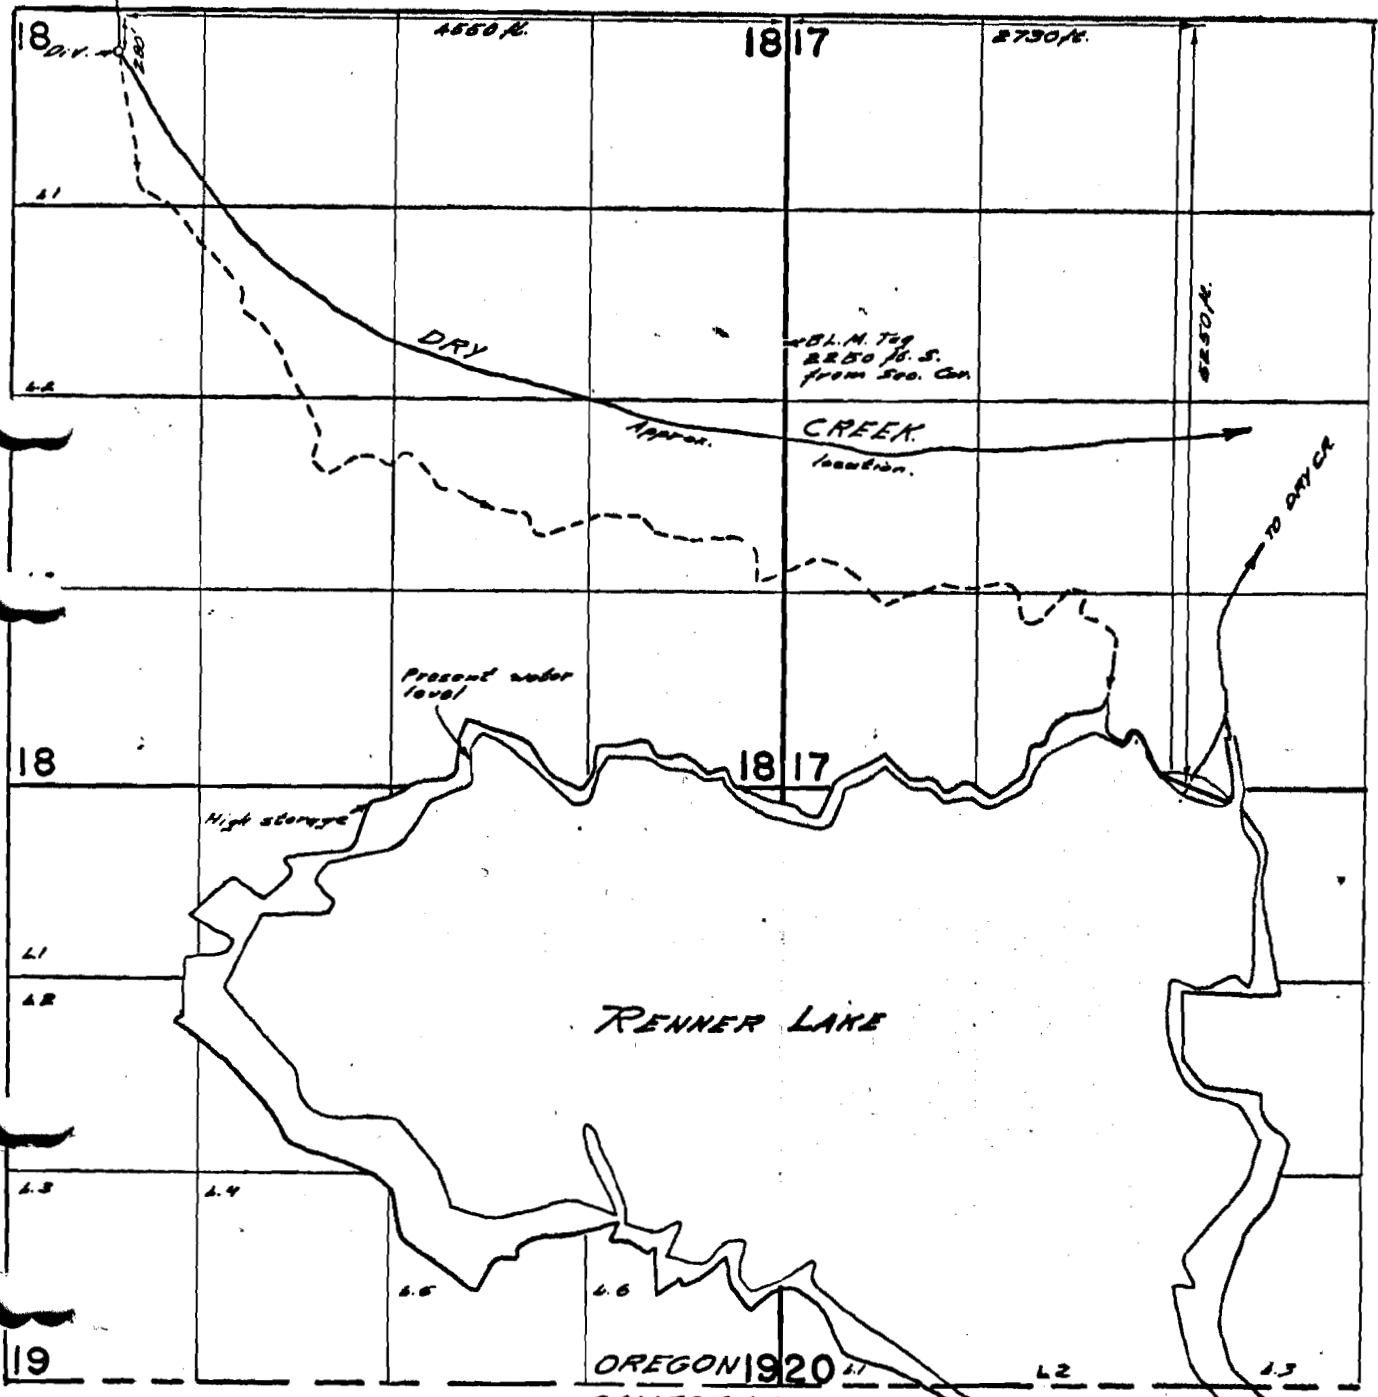

FINAL PROOF SURVEY UNDER

R-30867 R-1878
 Application No. ~~R-34028~~ Permit No. ~~R-2462~~
 IN NAME OF
R. T. RENNER
SECURITY PACIFIC NATIONAL BANK

Surveyed ~~Sept. 14, 1919~~ ~~1919~~ A.M. by ~~C. Gardner~~...

41-12