


24 208

Point Ranch
Portion

T. 41 S. R. 18 & 19 E. W.M

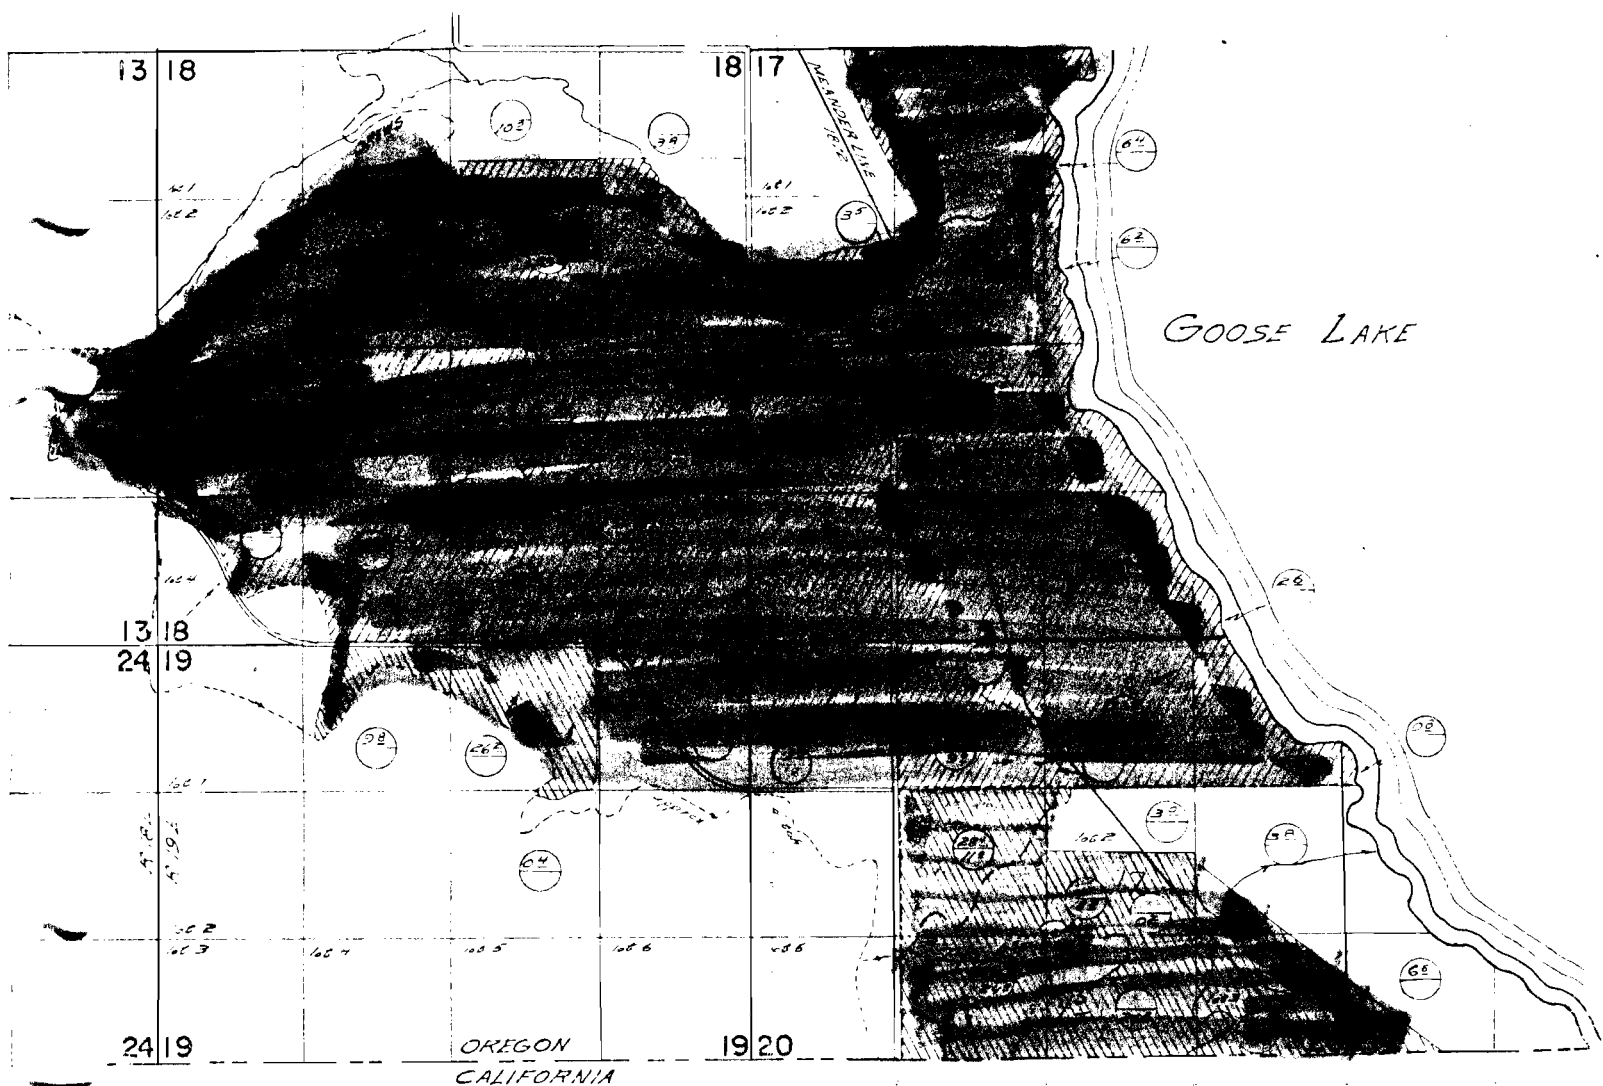

FINAL PROOF SURVEY

UNDER

APPLICATION No's. 27031, 32967 & 34260

PERMIT No's. [REDACTED] & 26920 24208

IN NAME OF

PACIFIC DEVELOPMENT COMPANY

SURVEYED SEPT 19 & 20, 1962 BY T. LAUER
AUG. 24 & 25, 1967 BY W.J. RUPPERT

○ PRIMARY
○ SUPPLEMENTAL

All irrigation under permit 26920 is supplemental

▨ PERMIT #'S 24208 & 26920

▨ PERMIT # 27041

Scale Reduced

242 208 18, 19 E. W.M. 1920