


T. 41 S. R. 18 E. W. M.

R-2462
37427

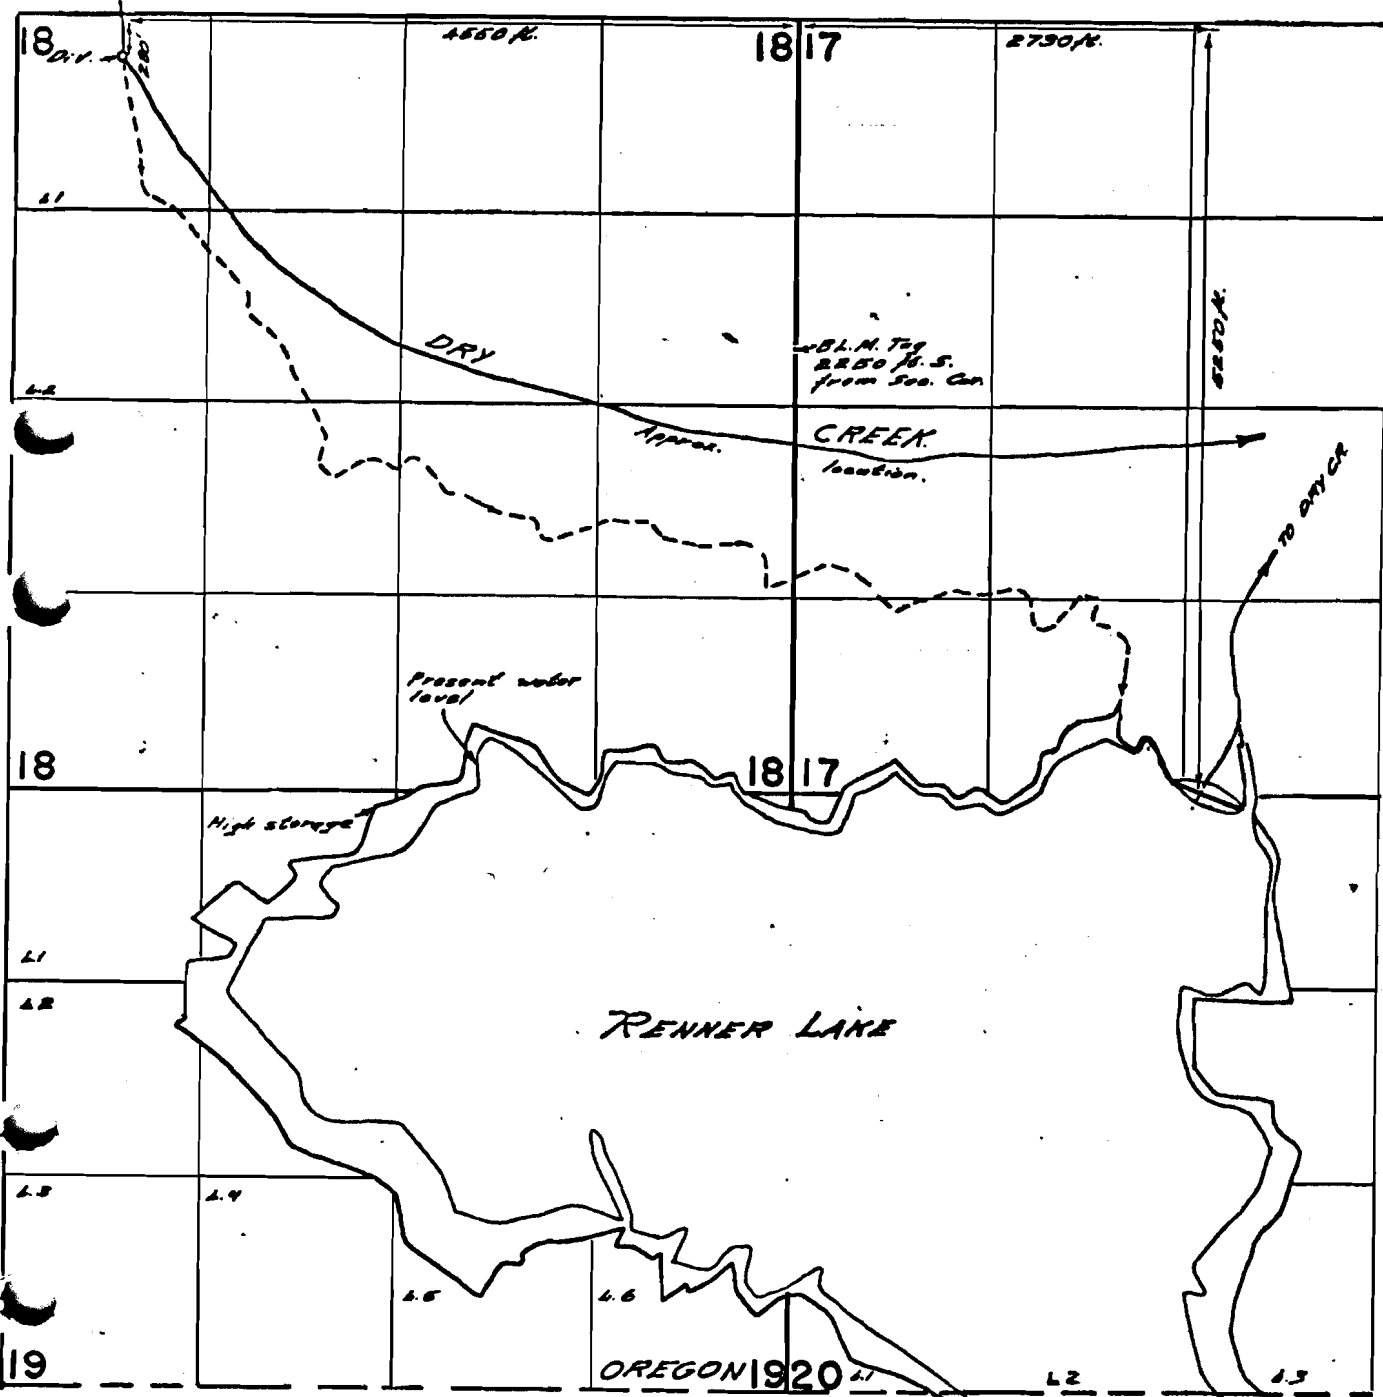

FINAL PROOF SURVEY
UNDER

R-30867 R-1878
Application No. R-34028B Permit No. R-2462
IN NAME OF
R. T. RENNER
SECURITY PACIFIC NATIONAL BANK

Surveyed Sept. 14, 1924 by C. Gardner

41-18