


27241

37429

T. 41 S. R. 18 & 19 E. W.M

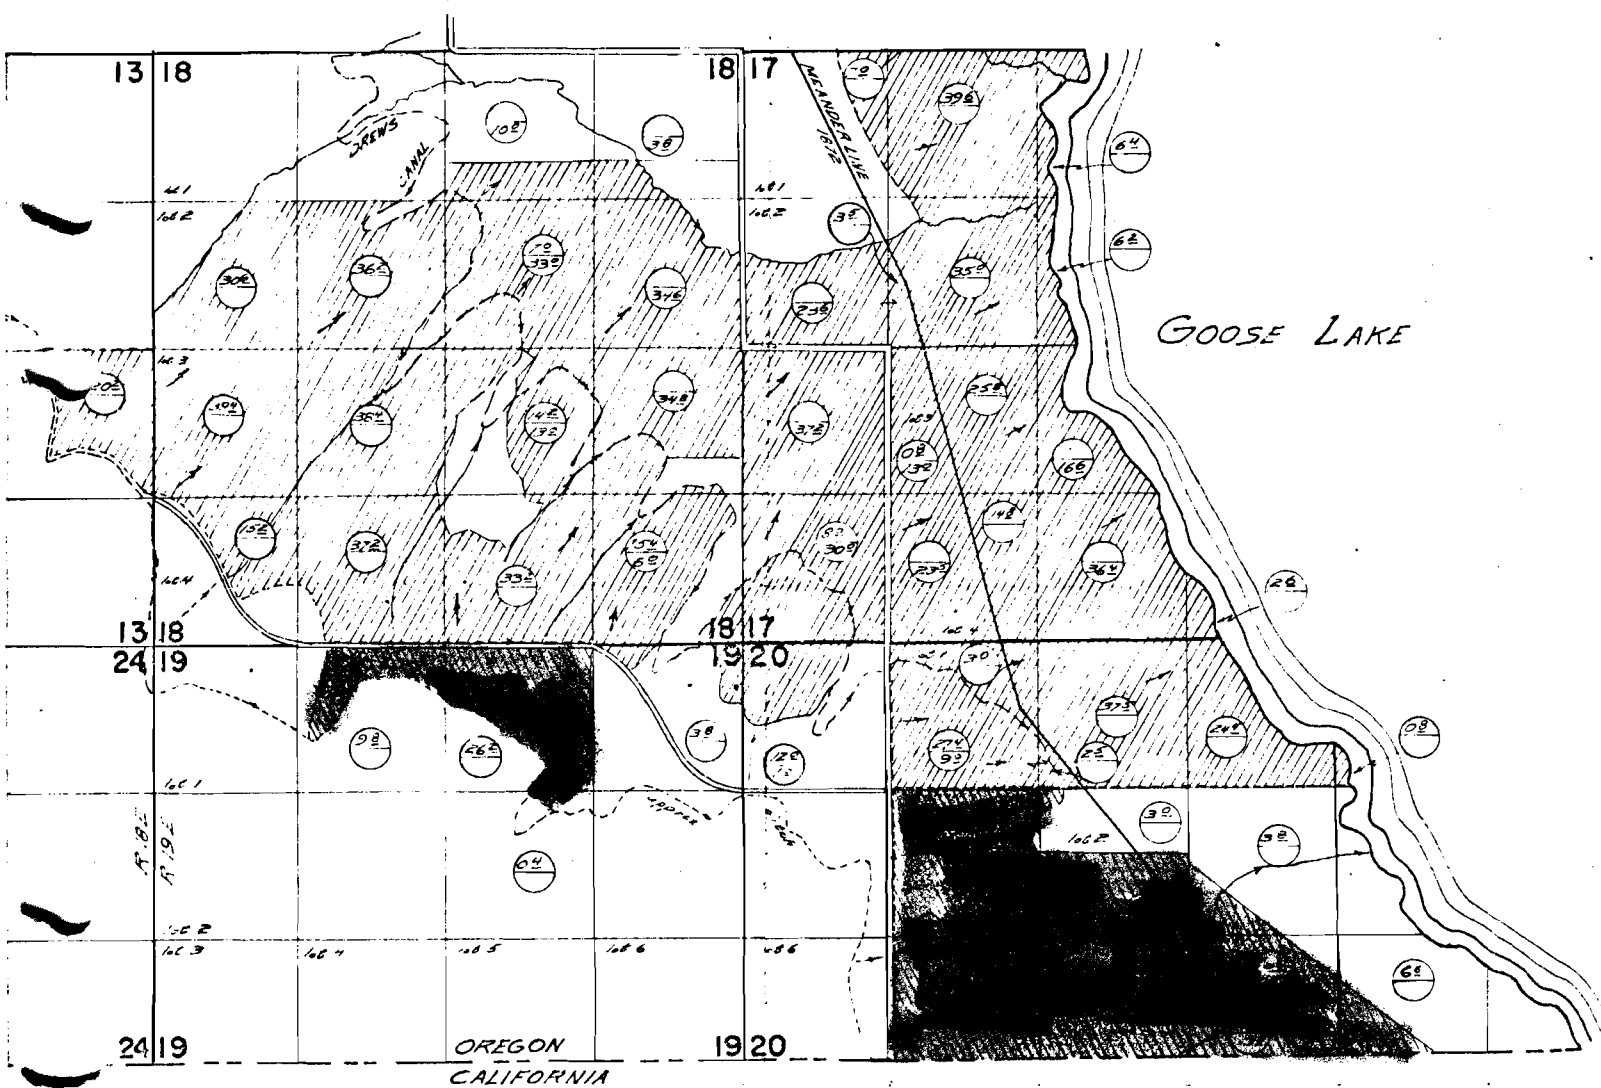

18 E.

FINAL PROOF SURVEY

UNDER

APPLICATION No's. 27031, 32967 & 34260
PERMIT No's. 24208, 27241 & 26920

IN NAME OF 27241

PACIFIC DEVELOPMENT COMPANY

SURVEYED SEPT 19 & 20, 1962 BY T. LAUER
AUG. 24 & 25, 1967 BY W.J. RUPPERT

○ PRIMARY
○ SUPPLEMENTAL

All irrigation under permit 26920 is supplemental

▨ PERMIT #'S 24208 & 26920

▨ PERMIT # 27241

14 13
23 29

27241 26920 24208 182 183 PTS 182 C, E