


31965
37430

T.40S.R.19E.W.M.

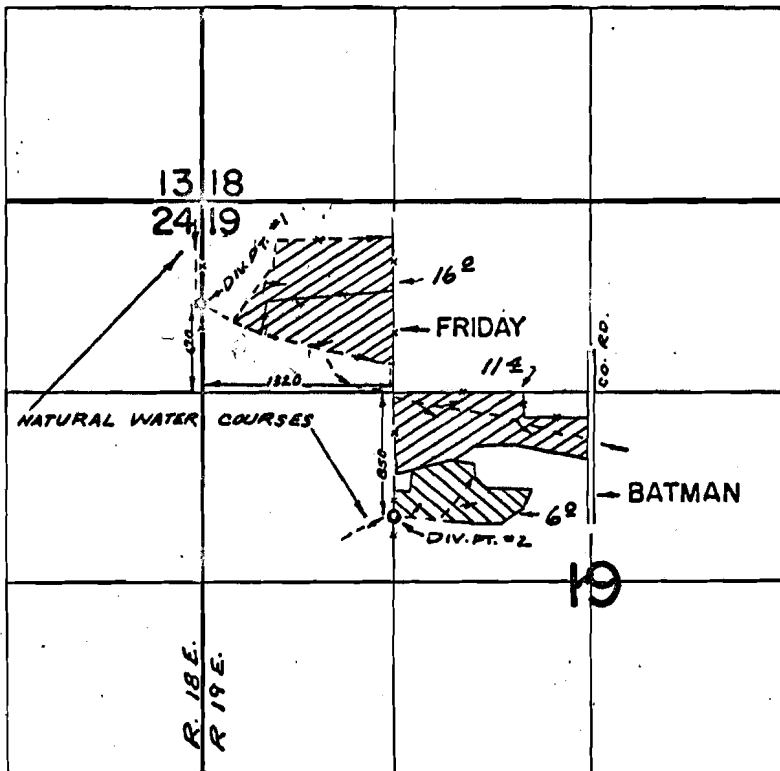

FINAL PROOF SURVEY

UNDER

Application No. 42372 Permit No. 31965

IN NAME OF

CECIL & IMOGENE BATMAN
DALE & SHIRLEY FRIDAY

Surveyed AUG. 4, 1970, by R. MUGGEN

40-19 ✓