


31966
37431

T.40S.R.19E.W.M.

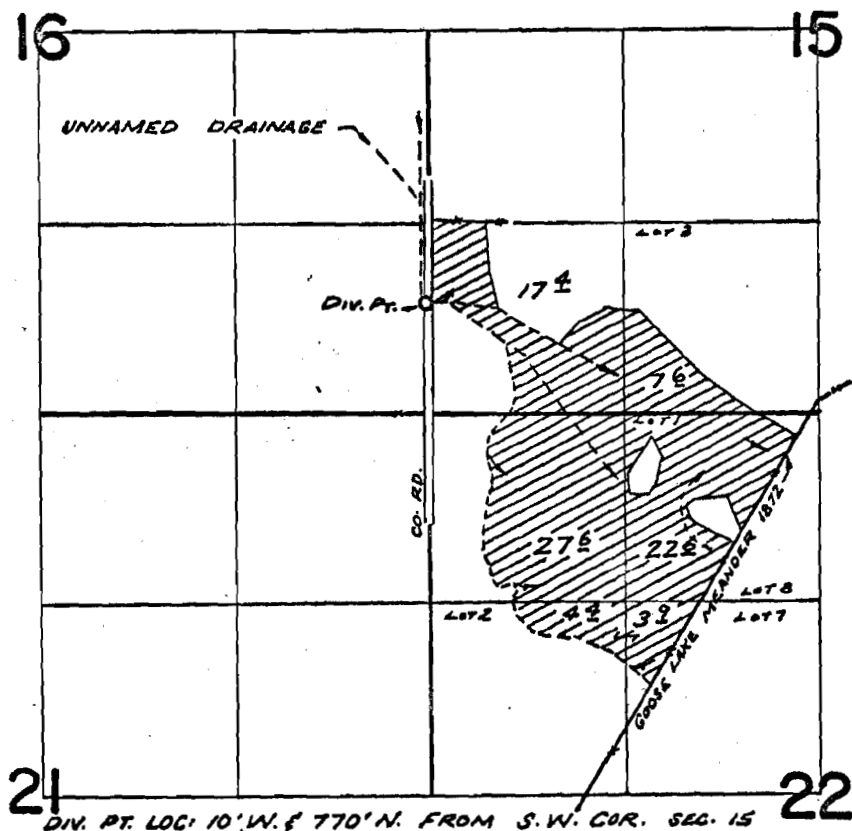

FINAL PROOF SURVEY

UNDER

Application No. 42373 Permit No. 31966

IN NAME OF

CECIL & IMOGENE BATMAN

Surveyed AUG. 4, 1970, by R. MUCKEN

40-19✓