


T. 17 S. R. 5 W. W.M.

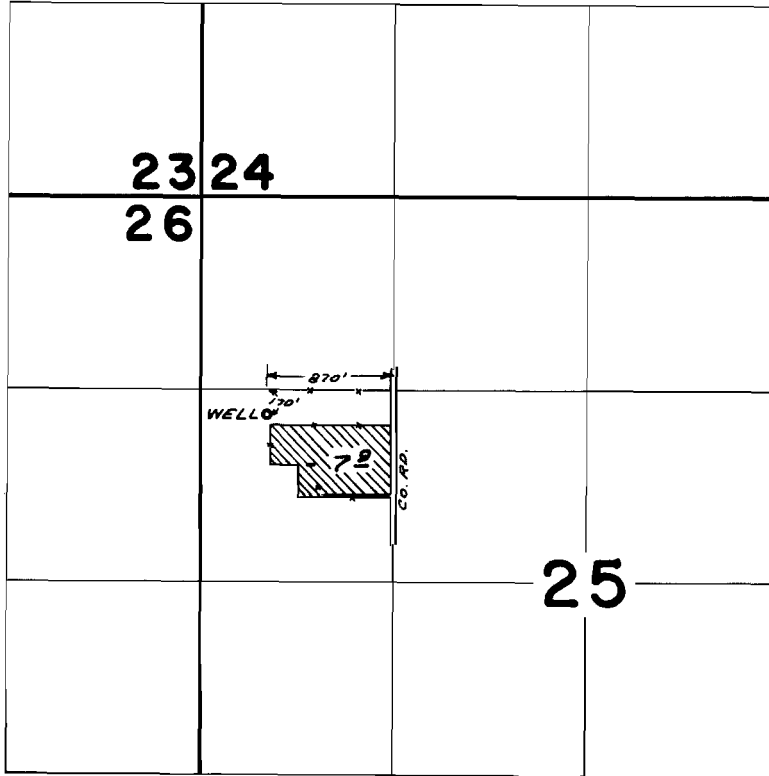

**FINAL PROOF SURVEY**  
UNDER

Application No. G-2934 Permit No. G-2732  
IN NAME OF

CARL E. LAIRD

Surveyed MAY 26 1969, by D. BUELL