


T.17 S. R. 5 W. W.M.

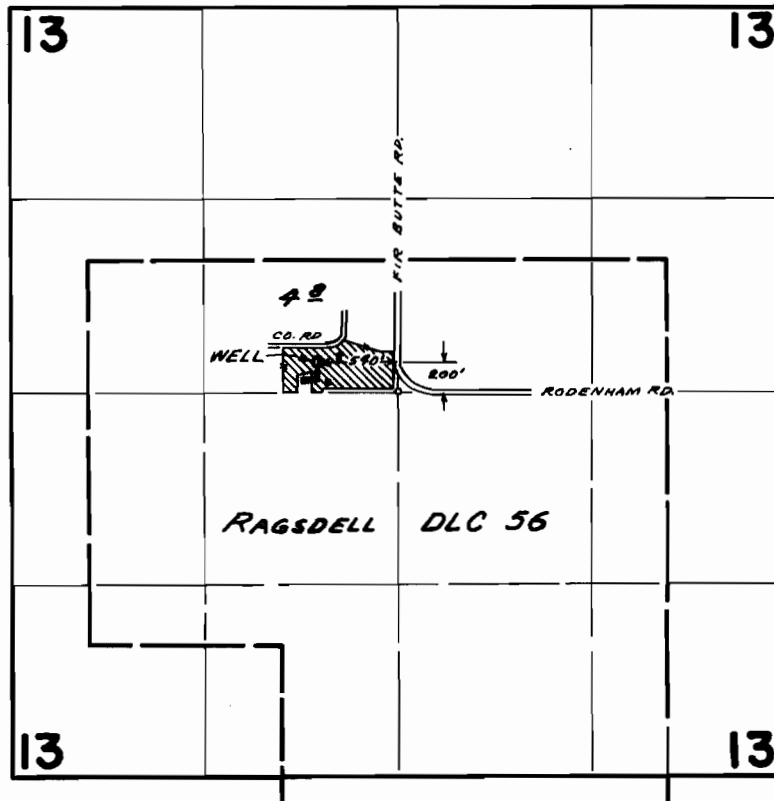

**FINAL PROOF SURVEY**  
UNDER

Application No. G-3160 Permit No. G-2973  
IN NAME OF

EBERT L. AND CAROL J. GRIESEL

Surveyed MAY 27 1969, by D. BUELL