


T.22S.R.3W.W.M.

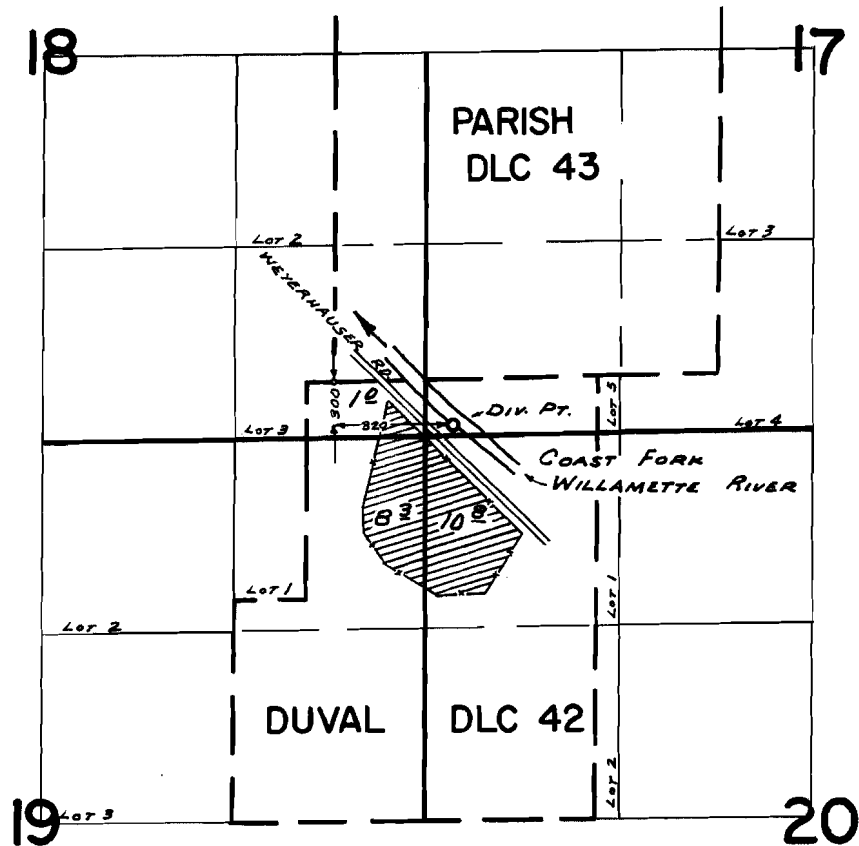

FINAL PROOF SURVEY
UNDER

Application No. 40324... Permit No. 30074...
IN NAME OF

WAYNE & MARJORIE H. BERGGREN

Surveyed APR. 29, 1969, by W. RUPPERT