


T.16 S.R.5 W.W.M.

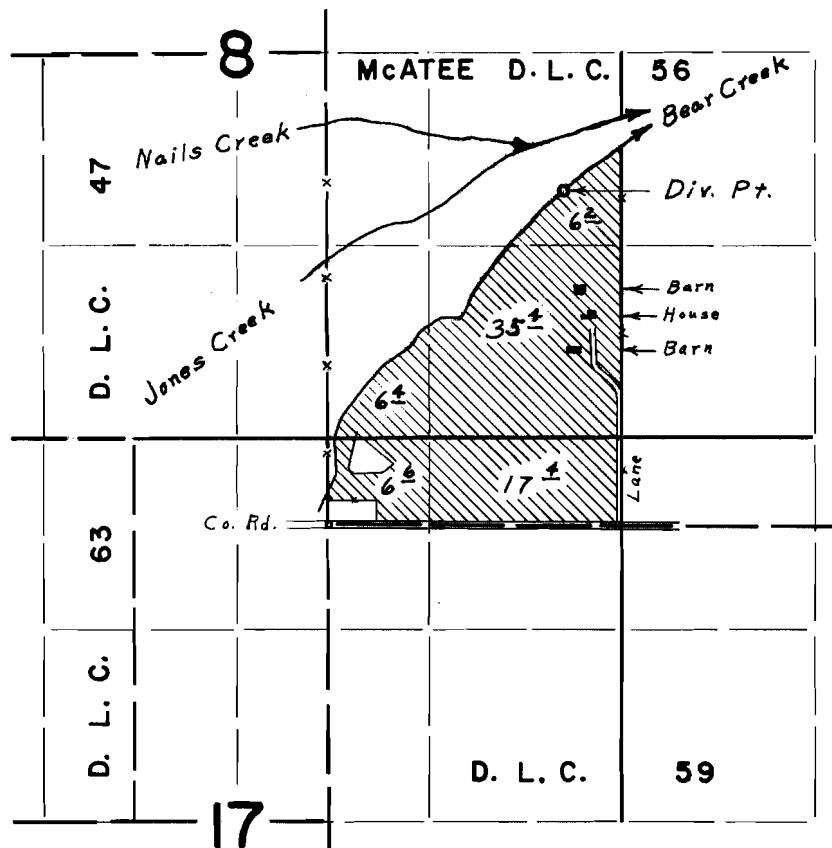

Div. Pt. located 2280' N. & 1620' E. from S.W. Cor. McAtee D.L.C. 56

FINAL PROOF SURVEY UNDER

Application No. 40434 Permit No. 30141
IN NAME OF

ORAN W. & FLORENCE M. BROWN

Surveyed April 22 1969, by L. E. Gould