


T.16 S. R. 6 W. W.M.

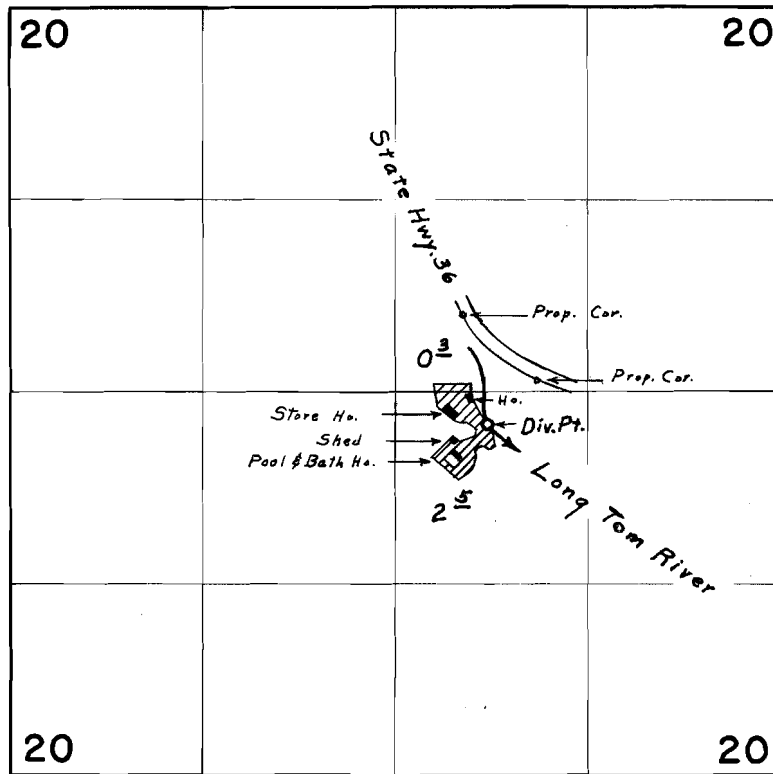

Div. Pt. located 2860' S & 630' E. from North & Cor. Sec. 20

**FINAL PROOF SURVEY**  
UNDER

Application No. 40438... Permit No. 30144...  
IN NAME OF

**CAMP LUTHERWOOD**

Surveyed April 18, 1969, by L. E. Gould