


N

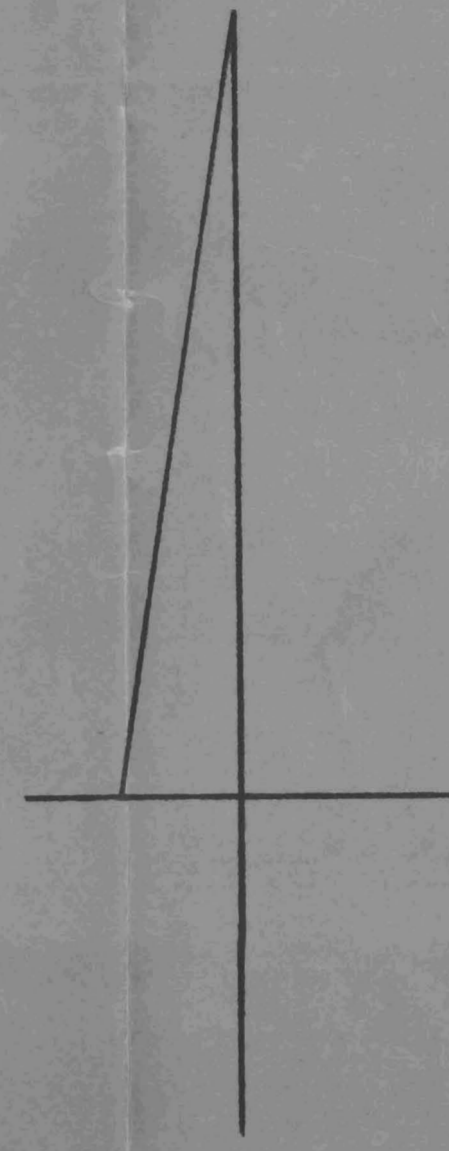

T.6 S. R.11 W.  
T.7 S. R.11 W.

Diversion point & pump  
house: S. 48° 30' W.  
2040' from N.E. corner  
Sec. 12, T.7 S., R.11 W., M.

RECEIVED  
AUG 30 1965  
STATE ENGINEER  
SALEM OREGON

Application No. 40401  
Permit No. 30626

CAUFIELD & CAUFIELD  
Consulting Engineers  
402 Pearson Building  
418 S. W. Washington Street  
Portland 4, Oregon

CITY OF  
OCEANLAKE, OREGON  
WATER SUPPLY

--- SUPPLY + DISTRIBUTION MAINS  
||||||| BOUNDARY OF SERVICE AREA

Scale: 1" = 825'

